

UNION
A16
3-68

MISSISSIPPI
BOARD OF WATER COMMISSIONERS
416 North State Street
Jackson, Mississippi 39201

CODED

WATER WELL DRILLERS LOG

3-18 19 68 Ed Clark Union
date well completed firm name county well located

LANDOWNER:

Mary Swane
Myrtle, Miss. R#
(mailing address)

description of formations encountered

from to

Shale	0	30
Rock & Sand	30	70
Blue mud	70	270
Rock & Sand	270	300
Blue mud	300	370
Rock & Sand	370	390
Blue mud	390	435
Rock & Sand	435	500

WELL LOCATION:

sec. 35 T. 6 N. R. 1 E
10 miles SW of Myrtle
(distance) (direction) (nearest town)


WELL PURPOSE:

Home
(home, irrigation, municipal, industrial)

WELL COMPLETION DATA:

- diameter (inches) 4"
- total depth (feet) 500 ft.
- static water level (feet) 60 ft. below top of ground.
- casing METAL 84 ft (material) (depth)
No (size) if telescope see back.
- screen No. (length) (depth to top)
No. (size) (material)
- pump 1-1/2 HP 10 (yield (gpm))
Elect (type power)
- electric log No (yes or no)
No (organization running log)
- how well bottom plugged No


CODED

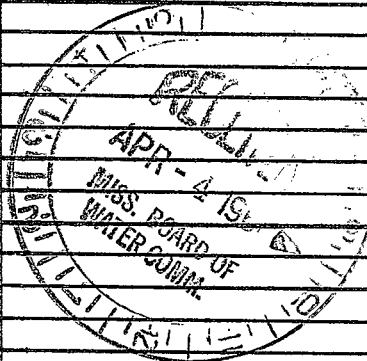

DRILLERS REMARKS:

If well telescopes please sketch and show depths.

GROUND LEVEL

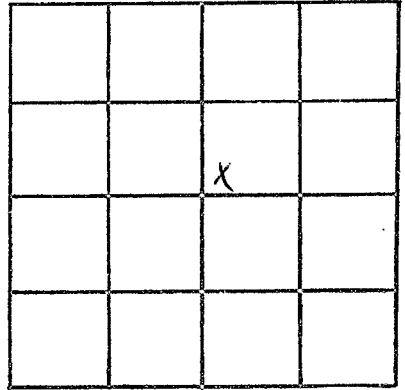

SECTION 35

Please indicate well location X.

ADDITIONAL INFORMATION

If more than one screen, show locations of each on sketch.