

Union
A 17
7-19-68

MISSISSIPPI
BOARD OF WATER COMMISSIONERS
416 North State Street
Jackson, Mississippi 39201

CODED

WATER WELL DRILLERS LOG

7-19-1968 Ed Clark Con. Union
date well completed firm name county well located

LANDOWNER:
S. D. Clark
Hickory Flat Rt. 2.
(mailing address)


description of formations encountered	from to	
<u>Clay</u>	<u>0</u>	<u>20</u>
<u>Rock & Sand</u>	<u>20</u>	<u>200</u>
<u>Blue mud</u>	<u>200</u>	<u>400</u>
<u>Rock & Sand</u>	<u>400</u>	<u>528</u>

WELL LOCATION:
sec. 3 T. 6 N. R. 1 E.
4 miles SE of Hickory Flat
(distance) (direction) (nearest town)

WELL PURPOSE: Home
(home, irrigation, municipal, industrial)

- WELL COMPLETION DATA:
- (1) diameter (inches) 4"
 - (2) total depth (feet) 528'
 - (3) static water level (feet) 40' below top of ground.
 - (4) casing Metal, 4 1/2"
(material) (depth)
 - 4"
(size) if telescope see back.
 - (5) screen None
(length) (depth to top)
 - (size) (material)
 - (6) pump 1/2 Sub 10
(HP) (yield gpm)
 - Electric
(type power)
 - (7) electric log No
(yes or no)
 - (organization running log)
 - (8) how well bottom plugged No


CODED

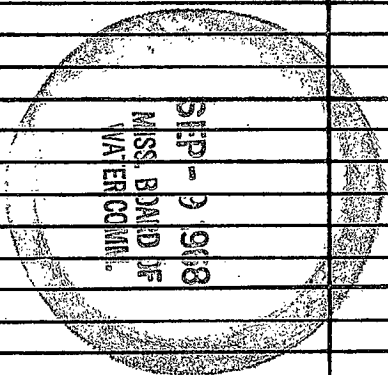

DRILLERS REMARKS:

If well telescopes please sketch and show depths.

GROUND LEVEL

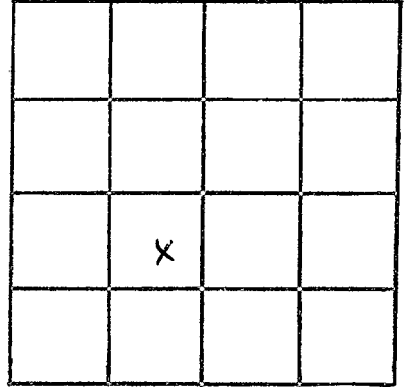

SECTION _____

Please indicate well location X.

ADDITIONAL INFORMATION

If more than one screen,
show locations of each on sketch.