

UNION
A18
1-6-72

CODED
MISSISSIPPI

BOARD OF WATER COMMISSIONERS
416 North State Street
Jackson, Mississippi 39201

812.50
4250
834.00

CODED

WATER WELL DRILLERS LOG

1-6 1972 JT Medicine UNION
date well completed firm name county well located

LANDOWNER: Carey Stinao description of formations encountered from to
R# 2 Myrtle 1/2 clay 0 25
Rock + sand 25 260
260 290
(mailing address)

WELL LOCATION:
sec. 14 T 6 N R 1 E
4 miles S of Myrtle
(distance) (direction) (nearest town)

WELL PURPOSE:
(home, irrigation, municipal, industrial)


- WELL COMPLETION DATA:
- (1) diameter (inches) 4
 - (2) total depth (feet) 390
 - (3) static water level (feet) 72 below above top of ground.
 - (4) casing P 83
(material) (depth)
(size) If telescope see back.
 - (5) screen _____
(length) (depth to top)
(size) (material)
 - (6) pump 3/4 6
(HP) (yield gpm)
C
(type power)
 - (7) electric log _____
(yes or no)
(organization running log)
 - (8) how well bottom plugged _____

DRILLERS REMARKS:

CODED

If well telescopes please sketch and show depths.

GROUND LEVEL

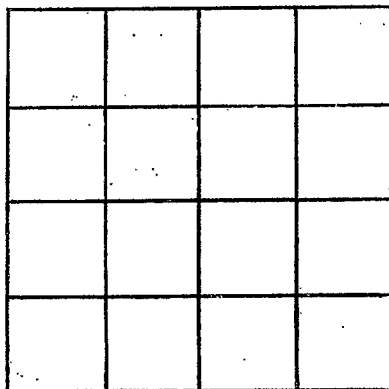

SECTION _____

Please indicate well location X.

ADDITIONAL INFORMATION

If more than one screen,
show locations of each on sketch.