

Union  
 FEB 1972  
 A 19  
 1-11 MISS. AD. IN STATE 72

MISSISSIPPI  
 BOARD OF WATER COMMISSIONERS  
 416 North State Street  
 Jackson, Mississippi 39201

476.00  
 2380  
 499.80  
 1972

WATER WELL DRILLERS LOG

1 11 1972 J.T. Medlin Union  
 date well completed firm name county well located

LANDOWNER:	description of formations encountered	from	to
L.D. Howell			
Maddonia	W. clay	0	17
Store R# Mentle (mailing address)	B. Rock & sand	17	488
		433	445

WELL LOCATION:  
 sec. 33 T 6 R 1 E  
 1 miles N of Maddonia  
 (distance) (direction) (nearest town)

WELL PURPOSE:  
 (home, irrigation, municipal, industrial)


- WELL COMPLETION DATA:
- diameter (inches) 4
  - total depth (feet) 545
  - static water level (feet) 35 below above top of ground.
  - casing (material) P (depth) 75  
 (size) if telescope see back.
  - screen (length) (depth to top)  
 (size) (material)
  - pump none (HP) (yield gpm)  
 (type power)
  - electric log (yes or no)  
 (organization running log)
  - how well bottom plugged

CODED

DRILLERS REMARKS:

If well telescopes please sketch and show depths.

GROUND LEVEL

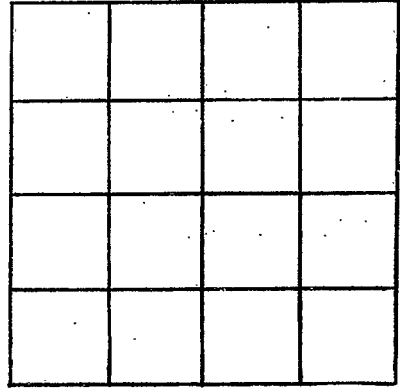

SECTION \_\_\_\_\_

Please indicate well location X.

ADDITIONAL INFORMATION

If more than one screen,  
show locations of each on sketch.