

Union
A 24
5-3-73

MISSISSIPPI
 BOARD OF WATER COMMISSIONERS
 416 North State Street
 Jackson, Mississippi 39201

900.00
 500
 400
CODED

WATER WELL DRILLERS LOG

5-3 1973 J-T Medlin UNION
 date well completed firm name county well located

LANDOWNER: Earl Lewis
Star Hill
Hickory Flat
 (mailing address)

description of formations encountered
Clay
rock + sand
 from 0 to 380
 380 460

WELL LOCATION:
 sec. 3 T. E N. R. 1 E
6 miles NW of Dandee
 (distance) (direction) (nearest town)

WELL PURPOSE:
 (home, irrigation, municipal, industrial)

WELL COMPLETION DATA:

- (1) diameter (inches) 4
- (2) total depth (feet) 460
- (3) static water level (feet) 20 below top of ground
- (4) casing P (material), 100 (depth)
- if telescope see back. (size)
- (5) screen (length), (depth to top)
- (size), (material)
- (6) pump 3/4 (HP), 6 (yield gpm)
- E (type power)
- (7) electric log X (yes or no)
- (organization running log)
- (8) how well bottom plugged

CODED


JUN 10 1973
 JUN 12 1973

DRILLERS REMARKS:

MISS. BD. OF
 WATER COM.

If well telescopes please sketch and show depths.

GROUND LEVEL

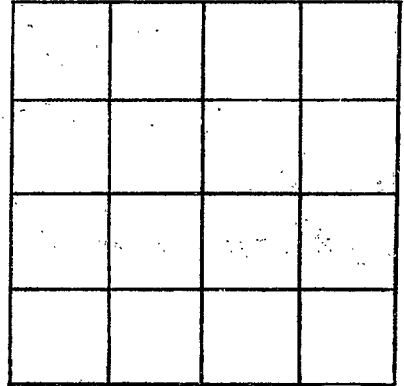

SECTION _____

Please indicate well location X.

ADDITIONAL INFORMATION

If more than one screen, show locations of each on sketch.