

UNION
A 25
7-25-73

MISSISSIPPI
BOARD OF WATER COMMISSIONERS
416 North State Street
Jackson, Mississippi 39201

CODED

WATER WELL DRILLERS LOG

July 25 1973 Billy R. Simpson UNION
date well completed firm name county well located

LANDOWNER:

GRADY HUDSON
HICKORY FLAT, MISS
(mailing address)

description of formations encountered

	from	to
<u>YELLOW CLAY</u>	<u>0</u>	<u>18</u>
<u>WHITE CLAY</u>	<u>18</u>	<u>66</u>
<u>ROCK</u>	<u>66</u>	<u>67</u>
<u>BLUE CLAY</u>	<u>67</u>	<u>120</u>
<u>ROCK</u>	<u>120</u>	<u>122</u>
<u>BLUE CLAY</u>	<u>122</u>	<u>502</u>
<u>ROCK</u>	<u>502</u>	<u>507</u>
<u>BLUE CLAY</u>	<u>507</u>	<u>520</u>
<u>ROCK + SAND</u>	<u>520</u>	<u>565</u>

WELL LOCATION:

sec. 2 T. 6 S. R. 1 E.
2 miles E of HICKORY FLAT
(distance) (direction) (nearest town)

WELL PURPOSE:

HOUSING
(home, irrigation, municipal, industrial)

WELL COMPLETION DATA:

- (1) diameter (inches) 4
- (2) total depth (feet) 565
- (3) static water level (feet) 135 below top of ground.
- (4) casing PVC, 240
(material) (depth)
If telescope see back.
(size)
- (5) screen None
(length) (depth to top)
(size) (material)
- (6) pump 3/4 10
(HP) (yield gpm)
ELEC.
(type power)
- (7) electric log No
(yes or no)
(organization running log)
- (8) how well bottom plugged 0


CODED

DRILLERS REMARKS:

AUG 6 1973

If well telescopes please sketch and show depths.

GROUND LEVEL

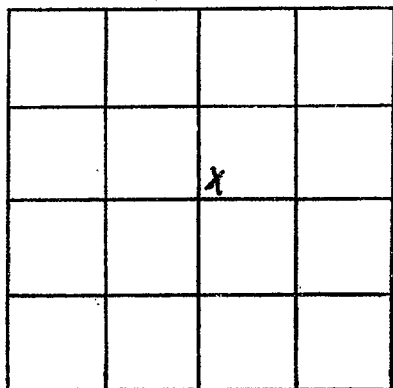

SECTION 2

Please indicate well location X.

ADDITIONAL INFORMATION

If more than one screen,
show locations of each on sketch.