

UNION
A26
2-28-74

MISSISSIPPI
 BOARD OF WATER COMMISSIONERS
 416 North State Street
 Jackson, Mississippi 39201

CODED

WATER WELL DRILLERS LOG

2-28
 date well completed

1974 J. W. Wehler & Sons
 firm name

Union
 county well located

LANDOWNER: <u>John H. Scott</u>	description of formations encountered	from	to
<u>Cornsville Miss</u> (mailing address)	<u>Soil</u>	<u>0</u>	<u>1</u>
WELL LOCATION: sec. <u>2</u> T. <u>6</u> N. R. <u>1</u> E <u>3</u> miles <u>South West</u> of <u>Myrtle</u> (distance) (direction) (nearest town)	<u>Sand & Clay</u>	<u>1</u>	<u>46</u>
WELL PURPOSE: (home, irrigation, municipal, industrial)	<u>Blue Rock sand</u>	<u>40</u>	<u>149</u>
WELL COMPLETION DATA: (1) diameter (inches) <u>4</u>	<u>Blue Rock</u>	<u>149</u>	<u>410</u>
(2) total depth (feet) <u>68.5</u>	<u>Water Rock</u>	<u>410</u>	<u>415</u>
(3) static water level (feet) <u>117</u> below top of ground.	<u>Water sand & rocks</u>	<u>415</u>	<u>685</u>
(4) casing <u>Steel</u> , <u>168</u> (material) (depth) <u>4"</u> (size) if telescope see back.	<u>Ripley sand</u>		
(5) screen <u>0</u> , <u>0</u> (length) (depth to top)			
(6) pump <u>1/2</u> (HP), <u>8</u> (yield gpm) <u>Elac</u> (type power)			
(7) electric log _____ (yes or no) (organization running log)			
(8) how well bottom plugged _____			
DRILLERS REMARKS:			


CODED

RECEIVED
 MAR - 5 1974

MISS. BD. OF WATER CONTROL

If well telescopes please sketch and show depths.

GROUND LEVEL

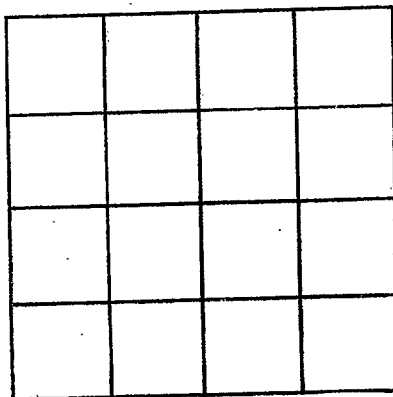

SECTION _____

Please indicate well location X.

ADDITIONAL INFORMATION

If more than one screen, show locations of each on sketch.