

**UNION**  
**A27**  
**4-18-74**

MISSISSIPPI  
 BOARD OF WATER COMMISSIONERS  
 416 North State Street  
 Jackson, Mississippi 39201

CODED

WATER WELL DRILLERS LOG

April 18 1974 J.W. Webb & Sons Union  
 Date well completed firm name county well located

LANDOWNER: John Fuller  
 672 Loch  
 Memphis Tenn.  
 (mailing address)

description of formations encountered	from	to
Soil	0	1
Red sand & clay	1	175
Blue Rock	175	514
Water Rock	514	518
Water sand & Rock	518	620
Replay sand		


WELL LOCATION:  
 sec. 10 T. 6 N R. 1 E  
 5 miles West of Myrtle  
 (distance) (direction) (nearest town)

WELL PURPOSE:  
 (home, irrigation, municipal, industrial)

- WELL COMPLETION DATA:
- (1) diameter (inches) 4
  - (2) total depth (feet) 620
  - (3) static water level (feet) 121 below top of ground.
  - (4) casing steel, 189 (depth)  
 4" (size) if telescope see back.
  - (5) screen 0 (length), 0 (depth to top)  
 (size) (material)
  - (6) pump 3/4 HP, 10 (yield gpm)  
 Elec (type power)
  - (7) electric log (yes or no)  
 (organization running log)
  - (8) how well bottom plugged


CODED

DRILLERS REMARKS:

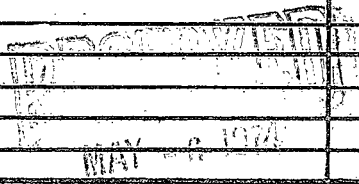

If well telescopes please sketch and show depths.

GROUND LEVEL

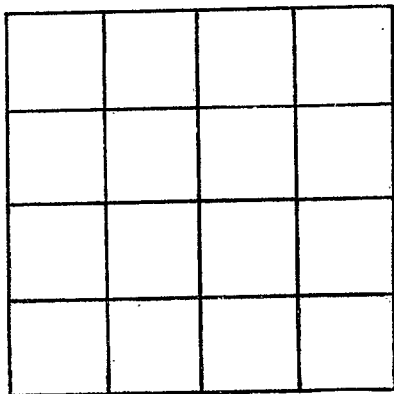

SECTION \_\_\_\_\_

Please indicate well location X.

ADDITIONAL INFORMATION

If more than one screen, show locations of each on sketch.