

Union
A 28
4-22-74

MISSISSIPPI
BOARD OF WATER COMMISSIONERS
416 North State Street
Jackson, Mississippi 39201

WATER WELL DRILLERS LOG

4-22 1974 J. W. Webb & Son Union
date well completed firm name county well located

LANDOWNER: Thomas Major
53495 Iruing
Memphis Tenn
(mailing address)

description of formations encountered	from	to
5' Red	0	7
Sand & Clay	1	218
Blue Rock	210	491
Water Rock	491	493
Water Sand & Rock	493	580
Replay sand		


WELL LOCATION:
sec. 12 T. 6 N R. 1 E
2.15 miles Northwest Myrtle
(distance) (direction) (nearest town)

WELL PURPOSE:
(home, irrigation, municipal, industrial)

- WELL COMPLETION DATA:
- (1) diameter (inches) 4"
 - (2) total depth (feet) 580
 - (3) static water level (feet) 93 below top of ground.
 - (4) casing Steel, 231' (material), (depth)
4 (size) if telescope see back.
 - (5) screen 0 (length), 0 (depth to top)
0 (size), 0 (material)
 - (6) pump 1/2 HP Sub B (HP), (yield gpm)
Elec (type power)
 - (7) electric log (yes or no)
(organization running log)
 - (8) how well bottom plugged


CODED

DRILLERS REMARKS:

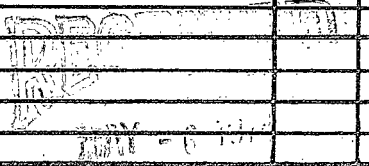

If well telescopes please sketch and show depths.

GROUND LEVEL

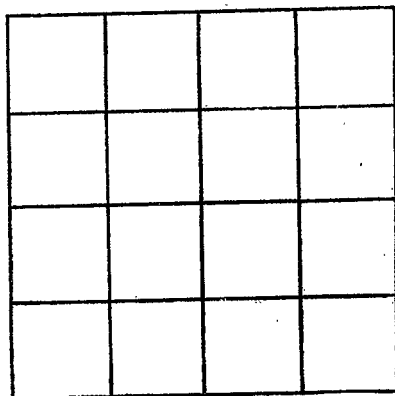

SECTION _____

Please indicate well location X.

ADDITIONAL INFORMATION

If more than one screen,
show locations of each on sketch.