

UNION
A 29
9-12-74

MISSISSIPPI
BOARD OF WATER COMMISSIONERS
416 North State Street
Jackson, Mississippi 39201

CODED

WATER WELL DRILLERS LOG

Sept 12 1974 J. J. Melvin UNION
date well completed firm name county well located

LANDOWNER: Tommy Roser
Myrtle Miss
(mailing address)

description of formations encountered	from	to
	Clay	0
rock & sand	284	360

WELL LOCATION:
sec. 12 T. 6 N. R. 1 E.
3 miles S of Myrtle
(distance) (direction) (nearest town)

WELL PURPOSE:
(home, irrigation, municipal, industrial)

WELL COMPLETION DATA:

(1) diameter (inches) 4

(2) total depth (feet) 360

(3) static water level (feet) 93 below top of ground.

(4) casing P 100 (material) (depth)

(size) If telescope see back.

(5) screen (length) (depth to top)

(size) (material)

(6) pump 1/2 6 (HP) (yield gpm)

(type power)

(7) electric log (yes or no)

(organization running log)

(8) how well bottom plugged

DRILLERS REMARKS:


CODED

DEC 12 1974

MISS. Bd. of Water Comm.

If well telescopes please sketch and show depths.

GROUND LEVEL

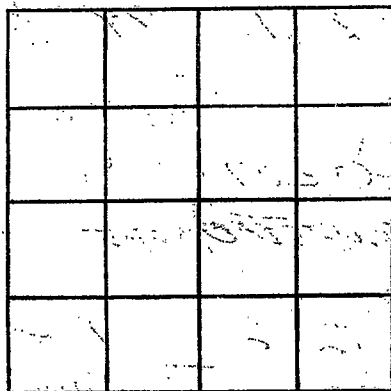

SECTION _____

Please indicate well location X.

ADDITIONAL INFORMATION

If more than one screen, show locations of each on sketch.