

Union
A 30
9-15-75

MISSISSIPPI
BOARD OF WATER COMMISSIONERS CODED
416 North State Street
Jackson, Mississippi 39201

WATER WELL DRILLERS LOG

Sept 15 1975 Billy R. Simpson UNION
date well completed firm name county well located

LANDOWNER:	description of formations encountered	from	to
GEORGE HOUSE	SURFACE CLAY	0	8
MYRTLE, MISS	WHITE + YELLOW CLAY	8	18
(mailing address)	SAND	18	30
WELL LOCATION:	BLUE CLAY	30	58
sec 7 T 6 R 1 E 15F	ROCK	58	59
4 1/2 miles S of HICKORY FLAT	BLUE CLAY	59	119
(distance) (direction) (nearest town)	ROCK	119	120
WELL PURPOSE: HOME	BLUE CLAY	120	152
(home, irrigation, municipal, industrial)	ROCK	152	153
WELL COMPLETION DATA:	BLUE CLAY	153	435
(1) diameter (inches) 4	LIMESTONE + SAND	435	475
(2) total depth (feet) 530	BLUE CLAY	475	509
(3) static water level (feet) 25 below top of ground	LIMESTONE + SAND	509	530
(4) casing POC 118 (material) (depth)			
(size) If telescope see back.			
(5) screen NONE (length) (depth to top)			
(size) (material)			
(6) pump 1/2 (HP) 10 (yield gpm)			
Elec (type power)			
(7) electric log No (yes or no)			
(organization running log)			
(8) how well bottom plugged			
DRILLERS REMARKS:			


CODED

RECEIVED
SEP 15 1975

SEP 15 1975

If well telescopes please sketch and show depths.

GROUND LEVEL

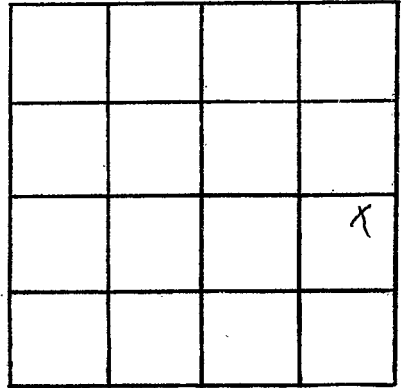

SECTION 7

Please indicate well location X.

ADDITIONAL INFORMATION

If more than one screen, show locations of each on sketch.