

UNION
A31
9-11-75

MISSISSIPPI
BOARD OF WATER COMMISSIONERS
416 North State Street
Jackson, Mississippi 39201

ISF

WATER WELL DRILLERS LOG


SEPT. 11 1975 ~~ALD~~ Union
date well completed firm name county well located
J. E. Martin

LANDOWNER:	description of formations encountered	from	to
Thelma Burnett			
Marta (mailing address)	100 ft. sand		
WELL LOCATION: sec. 2 (T) 6 (N) 3 (S) R 1 E 3 miles (distance) S (direction) of Martin (nearest town)	376 ft. sand CLAY	0	250
WELL PURPOSE: (home, irrigation, municipal, industrial)	sand + rock	250	316
WELL COMPLETION DATA:			
(1) diameter (inches) 4			
(2) total depth (feet) 316			
(3) static water level (feet) 100 below top of ground.			
(4) casing (material) P (depth) 100			
(size) if telescope see-back.			
(5) screen (length) (depth to top)	turn left on		
(size) (material)	Myrtle Posteville		
(6) pump (HP) (yield gpm)	Rd. - 2 miles		
(type power)	take left on		
(7) electric log (yes or no)	sec 4 end road		
(organization running log)			
(8) how well bottom plugged			
DRILLERS REMARKS:			

REGISTERED
OCT 1 8 1975

If well telescopes please sketch and show depths.

GROUND LEVEL

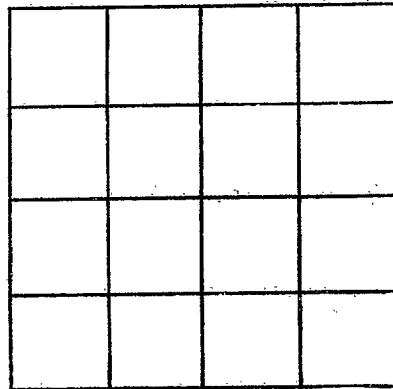

SECTION _____

Please indicate well location X.

ADDITIONAL INFORMATION

If more than one screen,
show locations of each on sketch.