

reed section

Union  
A 2000  
6/5/76

MISSISSIPPI  
BOARD OF WATER COMMISSIONERS  
416 North State Street  
Jackson, Mississippi 39201

WATER WELL DRILLERS LOG

UNION

6/5/76  
date/well completed

19 Mellin well drilling  
firm name

Marshall  
county well located

LANDOWNER: MR. Cecil Chunn

description of formations encountered

from to

Box Albany Miss.  
(mailing address)

Clay 0 30  
Clay + sand 30 90  
Clay 90 150  
Blue clay 150 430  
Sand flake 430 480

WELL LOCATION:

sec. T 6 N R 1 E  
3 miles West of Myrtle  
(distance) (direction) (nearest town)

WELL PURPOSE: Home  
(home, irrigation, municipal, industrial)

WELL COMPLETION DATA:

- (1) diameter (inches) 4
- (2) total depth (feet) 480
- (3) static water level (feet) 130 below top of ground.
- (4) casing P.V.C. 220' (material) (depth)
- (size) If telescope see back.
- (5) screen (length) (depth to top)
- (size) (material)
- (6) pump 1/2 (HP) 8 (yield gpm)
- Elec. (type power)
- (7) electric log (yes or no)
- (organization running log)
- (8) how well bottom plugged


DRILLERS REMARKS:

RECEIVED  
JUL 28 1976

MISS. Bd. OF WATER COMM

If well telescopes please sketch and show depths.

GROUND LEVEL

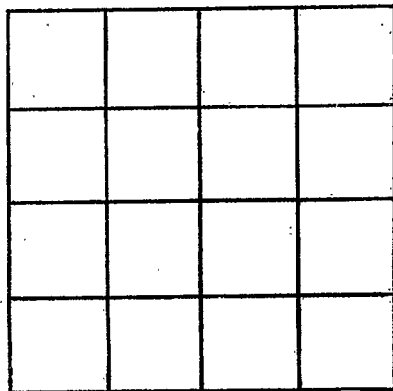

SECTION \_\_\_\_\_

Please indicate well location X.

ADDITIONAL INFORMATION

If more than one screen, show locations of each on sketch.