

need section

Union  
A 2001  
6-15-76

MISSISSIPPI  
BOARD OF WATER COMMISSIONERS  
416 North State Street  
15F Jackson, Mississippi 39201

WATER WELL DRILLERS LOG


6/15 date well completed  
1976 Medh Well Drilling Union firm name  
county well located

LANDOWNER: Randy Beckwith	description of formations encountered	from	to
Ella Miss. (mailing address)	Clay Blue Clay Rock & Sand	0 40 450	40 450 490
<b>WELL LOCATION:</b>			
sec. <u>6</u> T <u>6</u> N R <u>1</u> E 9 miles South of Potts Camp (distance) (direction) (nearest town)			
<b>WELL PURPOSE:</b> Home			
(home, irrigation, municipal, industrial)			
<b>WELL COMPLETION DATA:</b>			
(1) diameter (inches) <u>4"</u>			
(2) total depth (feet) <u>490'</u>			
(3) static water level (feet) <u>30</u> below top of ground.			
(4) casing <u>P.V.C.</u> <u>110'</u> (material) (depth)			
(size) if telescope see back.			
(5) screen (length) (depth to top)			
(size) (material)			
(6) pump <u>1/2</u> <u>10</u> (HP) (yield gpm)			
<u>Elec.</u> (type power)			
(7) electric log (yes or no)			
(organization running log)			
(8) how well bottom plugged			
<b>DRILLERS REMARKS:</b>			

RECEIVED  
JUL 28 1976  
MISS. BD. OF WATER COMM

If well telescopes please sketch and show depths.

GROUND LEVEL

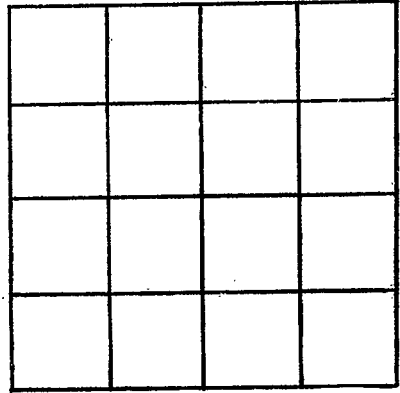

SECTION \_\_\_\_\_

Please indicate well location X.

ADDITIONAL INFORMATION

If more than one screen,  
show locations of each on sketch.