

Need see. #

Union
A 2000
6-22-76

MISSISSIPPI
BOARD OF WATER COMMISSIONERS
416 North State Street
Jackson, Mississippi 39201

WATER WELL DRILLERS LOG

6/22/76 19 Medlin Well Drilling Union
date well completed firm name county well located


LANDOWNER: Willis Hunt	description of formations encountered	from	to
Ethna Miss. (mailing address)	Clay Blue Clay Sand & Rock	0 110 450	40 450 510
WELL LOCATION: sec. <u>6</u> T. <u>6</u> N. R. <u>1</u> E. <u>9</u> miles <u>West</u> of <u>Wadsworth</u> (distance) (direction) (nearest town)			
WELL PURPOSE: <u>Home</u> (home, irrigation, municipal, industrial)			
WELL COMPLETION DATA:			
(1) diameter (inches) <u>4</u>			
(2) total depth (feet) <u>510</u>			
(3) static water level (feet) <u>40</u> below above top of ground.			
(4) casing <u>P.V.C.</u> <u>120</u> (material) (depth)			
(size) If telescope see back.			
(5) screen <u>✓</u> (length) (depth to top)			
(size) (material)			
(6) pump <u>1</u> <u>12</u> (HP) (yield gpm)			
<u>Elec.</u> (type power)			
(7) electric log (yes or no)			
(organization running log)			
(8) how well bottom plugged			
DRILLERS REMARKS:			

RECEIVED
APR 28 1976

MISS. BD. OF WATER COMMISSIONERS

If well telescopes please sketch and show depths.

GROUND LEVEL

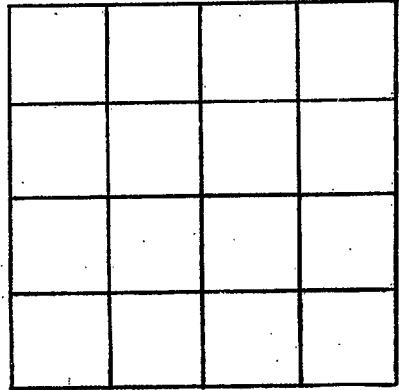

SECTION _____

Please indicate well location X.

ADDITIONAL INFORMATION

If more than one screen, show locations of each on sketch.