

UNION
A <u>2004</u>
3-13-78

**MISSISSIPPI
BOARD OF WATER COMMISSIONERS**
416 North State Street
Jackson, Mississippi 39201

WATER WELL DRILLERS LOG

3-13 1978 Leaper Union
 date well completed firm name county well located

LANDOWNER:
Tommy Turner
Star Pt. Myrtle
 (mailing address)

description of formations encountered	from	to
<u>Top clay</u>	<u>0</u>	<u>20</u>
<u>Blue clay</u>	<u>20</u>	<u>250</u>
<u>Chalk</u>	<u>250</u>	<u>375</u>
<u>Sand</u>	<u>375</u>	<u>425</u>

WELL LOCATION:
 sec 25 T 6 N R 1 (E)
3 miles W of Myrtle
 (distance) (direction) (nearest town)

WELL PURPOSE: Home
 (home, irrigation, municipal, industrial)

WELL COMPLETION DATA:

(1) diameter (inches) 4"

(2) total depth (feet) 425'

(3) static water level (feet) _____ below
 top of ground. above

(4) casing Steel, 84'
 (material) (depth)

_____ If telescope see back.
 (size)

(5) screen _____
 (length) (depth to top)

_____ (size) _____ (material)

(6) pump 3/4 10
 (HP) (yield gpm)

Electric
 (type power)

(7) electric log No
 (yes or no)

_____ (organization running log)

(8) how well bottom plugged open


DRILLERS REMARKS:

RECEIVED
 AUG 29 1978

MISS. BD. OF WATER COMM.

If well telescopes please sketch and show depths.

GROUND LEVEL

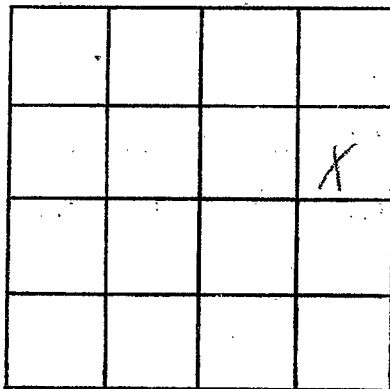

SECTION 25

Please indicate well location X.

ADDITIONAL INFORMATION

If more than one screen,
show locations of each on sketch.