

UNION
A 2005
5-15-78

**MISSISSIPPI
BOARD OF WATER COMMISSIONERS**
416 North State Street
Jackson, Mississippi 39201

WATER WELL DRILLERS LOG

5-15-1978 date well completed 19 Union firm name Union county well located

LANDOWNER: Floyd Dowdy, Jr.
Myrtle Miss.
(mailing address)

description of formations encountered	from	to
<u>Top sand</u>	<u>0</u>	<u>20</u>
<u>Blue clay</u>	<u>20</u>	<u>200</u>
<u>Chalk</u>	<u>200</u>	<u>320</u>
<u>Sand</u>	<u>320</u>	<u>400</u>

WELL LOCATION:
sec. 26 T. 6 N. R. 1 E
5 miles SW of Myrtle
(distance) (direction) (nearest town)

WELL PURPOSE: Home
(home, irrigation, municipal, industrial)

WELL COMPLETION DATA:

(1) diameter (inches) 4

(2) total depth (feet) 400

(3) static water level (feet) 120 below top of ground. (above)

(4) casing PVC
(material) (depth)

_____ if telescope see back.
(size)

(5) screen _____
(length) (depth to top)

_____ (size) _____ (material)
(6) pump 3/4 10
(HP) (yield gpm)

Elec.
(type power)

(7) electric log No
(yes or no)

_____ (organization running log)

(8) how well bottom plugged open

DRILLERS REMARKS:


Miss. Board of Water Comm.
Miss. Board of Water Comm.

FEB 16 1979

RECEIVED

If well telescopes please sketch and show depths.

GROUND LEVEL

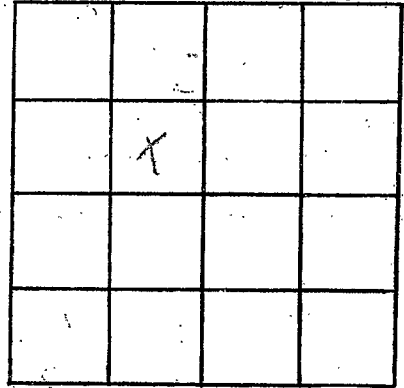

SECTION 26

Please indicate well location X.

ADDITIONAL INFORMATION

If more than one screen,
show locations of each on sketch.