

UNION
 A 2000
 7/06/79

MISSISSIPPI
 BOARD OF WATER COMMISSIONERS
 416 North State Street
 Jackson, Mississippi 39201

WATER WELL DRILLERS LOG

7/16 1979 J.T. Medina UNION
 date well completed firm name county well located

LANDOWNER:
 Robert Browning
 Myrtle Weiss
 (mailing address)

description of formations encountered	from	to
Clay	0	280
rock & sand	280	330
Clay	330	370
rock & sand	370	410

WELL LOCATION:
 sec 23 T 6 N R 1 E
 4 miles S of Myrtle
 (distance) (direction) (nearest town)

WELL PURPOSE:
 (home, irrigation, municipal, industrial)

WELL COMPLETION DATA:

(1) diameter (inches) 4

(2) total depth (feet) 410

(3) static water level (feet) 60 below top of ground.

(4) casing P 140 (material) (depth)
 (size) if telescope see back.

(5) screen (length) (depth to top)
 (size) (material)

(6) pump 5 8 (HP) (yield gpm)
 E (type power)

(7) electric log (yes or no)

(organization running log)

(8) how well bottom plugged

DRILLERS REMARKS:


Miss. Board of Water Comm.

AUG 22 1979

RECEIVED

If well telescopes please sketch and show depths.

GROUND LEVEL

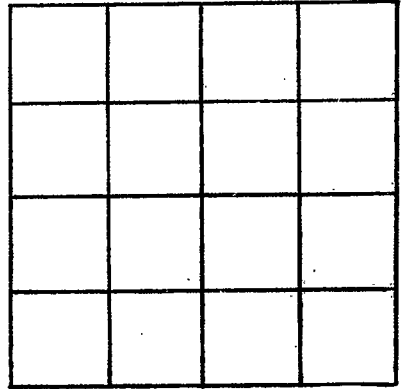

SECTION _____

Please indicate well location X.

ADDITIONAL INFORMATION

If more than one screen, show locations of each on sketch.