

UNION
 A 2007
 8-2-80

MISSISSIPPI
 BOARD OF WATER COMMISSIONERS
 416 North State Street
 Jackson, Mississippi 39201

WATER WELL DRILLERS LOG

Aug 2 1980
 date well completed

JT Medlin
 firm name

UNION
 county well located

LANDOWNER: ~~Johnny Garrison~~
 Johnny Garrison
 Macedonia HW 30 West
 New Albany (mailing address)

description of formations encountered	from	to
Clay	0	540
ROCK	540	680

WELL LOCATION:
 sec 32 6 N R 1 E
 S W
 3 1/2 miles Enterprise
 (distance) (direction) (nearest town)

WELL PURPOSE:
 (home, irrigation, municipal, industrial)

- WELL COMPLETION DATA:
- (1) diameter (inches) 4
 - (2) total depth (feet) 670
 - (3) static water level (feet) 36 below top of ground.
 - (4) casing P 190 (material) (depth)
 (size) if telescope see back.
 - (5) screen 50 630 (length) (depth to top)
 (size) (material)
 - (6) pump 1/2 10 (HP) (yield-gpm)
 E (type power)
 - (7) electric log (yes or no)
 (organization running log)
 - (8) how well bottom plugged

DRILLERS REMARKS:


DEPT. OF NATURAL RESOURCES
 BUREAU OF LAND & WATER RESOURCES

AUG 25 1980

RECEIVED

If well telescopes please
sketch and show depths.

GROUND LEVEL

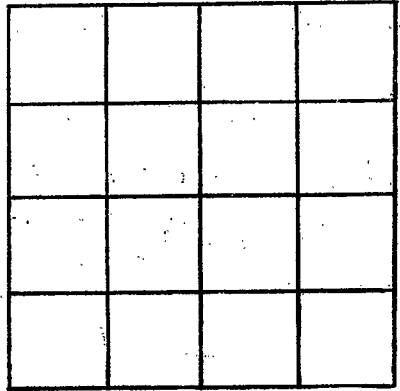

SECTION _____

Please indicate well location X.

ADDITIONAL INFORMATION

If more than one screen,
show locations of each on sketch.