

UNION  
A 2008  
12/10/80

MISSISSIPPI  
BOARD OF WATER COMMISSIONERS  
416 North State Street  
Jackson, Mississippi 39201

WATER WELL DRILLERS LOG

12/10/80 1980 F T Medlin Union  
date well completed firm name county well located

LANDOWNER: Frank L. Gibson  
1463 Marine Rd  
Memphis, Tenn  
(mailing address)

description of formations encountered	from	to
Clay	0	250
shell & sand	130	300

WELL LOCATION:  
sec 19 T S N R 1 E  
S W  
3 miles E of hurdle  
(distance) (direction) (nearest town)

WELL PURPOSE:  
(home, irrigation, municipal, industrial)

WELL COMPLETION DATA:

- (1) diameter (inches) 4
- (2) total depth (feet) 380
- (3) static water level (feet) 20 below above top of ground.
- (4) casing P 160  
(material) (depth)  
(size) If telescope see back.
- (5) screen (length) (depth to top)  
(size) (material)
- (6) pump 3 10  
(HP) (yield gpm)  
(type power)
- (7) electric log (yes or no)  
(organization running log)
- (8) how well bottom plugged 2 1/2"


DRILLERS REMARKS:

DEPT. OF NATURAL RESOURCES  
BUREAU OF LAND & WATER RESOURCES

MAR - 9 1981  
RECEIVED

If well telescopes please sketch and show depths.

GROUND LEVEL

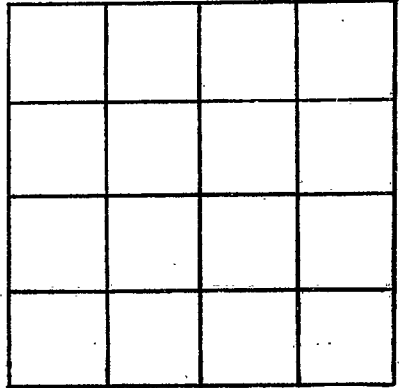

SECTION \_\_\_\_\_

Please indicate well location X.

ADDITIONAL INFORMATION

If more than one screen, show locations of each on sketch.