

Union
 A 2010
 6-7-81

MISSISSIPPI
 BOARD OF WATER COMMISSIONERS
 416 North State Street
 Jackson, Mississippi 39201

WATER WELL DRILLERS LOG

6-7-81 date well completed 1981 J.T. Medina firm name UNION county well located

LANDOWNER:
 Robert Williams
 Myrtle MS (mailing address)


description of formations encountered
 SAND & CLAY from 0 to 160
 Clay & Rock 160-260

WELL LOCATION:
 sec 17 T 6 N R 1 E
 6 miles E of GONDOPVILLE (nearest town)

SAND & SHELL 260-360

WELL PURPOSE:
 (home irrigation, municipal, industrial)


- WELL COMPLETION DATA:
- (1) diameter (inches) 4
 - (2) total depth (feet) 360
 - (3) static water level (feet) 60 (feet above top of ground)
 - (4) casing PVC 200 (material) (depth)
 - (size) If telescope see back.
 - (5) screen (length) (depth to top)
 - (size) (material)
 - (6) pump 1/2 (HP) 10 (yield gpm)
 Eje (type power)
 - (7) electric log (yes or no)
 - (organization running log)
 - (8) how well bottom plugged

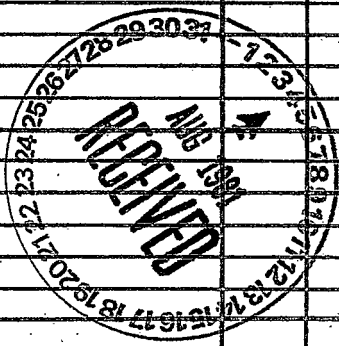

DRILLERS REMARKS:

If well telescopes please sketch and show depths.

GROUND LEVEL

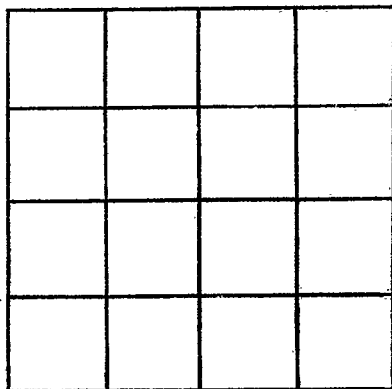

SECTION _____

Please indicate well location X.

ADDITIONAL INFORMATION

If more than one screen, show locations of each on sketch.