

Union
A
2012

MISSISSIPPI DEPARTMENT OF NATURAL RESOURCES
Bureau of Land and Water Resources
Southport Mall
P.O. Box 10631
Jackson, Mississippi 39209
WATER WELL DRILLERS LOG

4-17-1982 JT Medlin Union
date well completed firm name county well located

LANDOWNER:
John Hale
New Albany
(mailing address)

description of formations encountered	from	to
Clay - Rock	0	100
Sand - Clay	60	150
Clay - (stone)	150	240
Clay - Iron Rock	210	4100
Sand - Shell	4100	5000

WELL LOCATION:
sec. 10 T. 6N R. 1E
3 miles N/W Enterprise
(distance) (direction) (nearest town)

WELL PURPOSE:
(home, irrigation, municipal, industrial)

- WELL COMPLETION DATA:
- (1) diameter (inches) 4
 - (2) total depth (feet) 500
 - (3) static water level (feet) 90 below top of ground.
 - (4) casing PVC 100 (material) (depth)
 - (size) if telescope see back.
 - (5) screen (length) (depth to top)
 - (size) (material)
 - (6) pump 1/2 10 (HP) (yield gpm)
 - 810 (type power)
 - (7) electric log (yes or no)
 - (organization running log)
 - (8) how well bottom plugged

DEPT. OF NATURAL RESOURCES
BUREAU OF LAND & WATER RESOURCES


JUN 28 1982

RECEIVED

DRILLERS REMARKS:

If well telescopes please sketch and show depths.

GROUND LEVEL

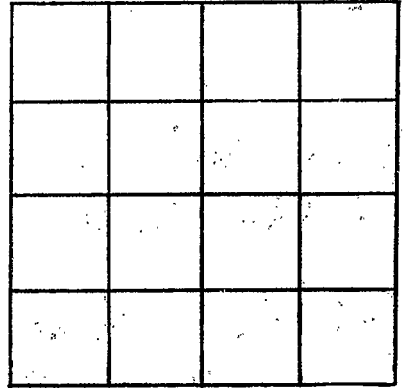

SECTION _____

Please indicate well location X.

ADDITIONAL INFORMATION

If more than one screen,
show locations of each on sketch.