

<u>Union</u>
<u>A</u>
<u>2014</u>

MISSISSIPPI DEPARTMENT OF NATURAL RESOURCES
 Bureau of Land and Water Resources
 Southport Mall
 P.O. Box 10631
 Jackson, Mississippi 39209
WATER WELL DRILLERS LOG

<u>10-17-</u>	19	<u>83 Medlin</u>	<u>Union</u>
date well completed		firm name	county well located

LANDOWNER: Fitzgerald
Mark Fitzgerald
Natch MS,
 (mailing address)

WELL LOCATION:
 sec 28 T E R 1 E W
4 miles SW Natch
 (distance) (direction) (nearest town)

WELL PURPOSE:
 (Home, irrigation, municipal, industrial)

WELL COMPLETION DATA:

(1) diameter (inches) 4

(2) total depth (feet) 350

(3) static water level (feet) 140 below above
 top of ground.

(4) casing PVC 280
 (material) (depth)
 (size) If telescope see back.

(5) screen 2 20
 (length) (depth to top)
 (size) (material)


(6) pump 2 1/2 12
 (HP) (yield gpm)
ELC
 (type power)

(7) electric log _____
 (yes or no)
 (organization running log) _____

(8) how well bottom plugged Open

description of formations encountered	from	to
to 120	0	120
top soil	0	120
rock		
clay limestone	120	350
limestone clay	350	350


DRILLERS REMARKS: _____

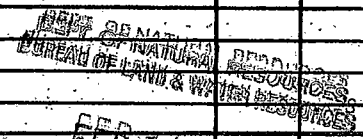

FEB 10 1984
RECEIVED

If well telescopes please sketch and show depths.

GROUND LEVEL

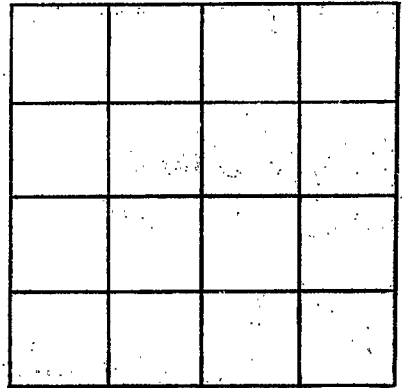

SECTION _____

Please indicate well location X.

ADDITIONAL INFORMATION

If more than one screen,
show locations of each on sketch.