

MISSISSIPPI DEPARTMENT OF NATURAL RESOURCES

Bureau of Land and Water Resources

Southport Mall

P.O. Box 10631

Jackson, Mississippi 39209

WATER WELL DRILLERS LOG

UNION
A
2017

August 1986  
date well completed

Leeper Drilling  
firm name

UNION  
county well located


LANDOWNER: Bruce Perkins  
Rt 2 Hickory Flat MS.  
(Cornersville Community)  
(mailing address)

description of formations encountered	depth	
	from	to
Top clay	0	20
Blue clay	20	360
Chalk	360	520
Sand	520	570

WELL LOCATION:  
sec. 33 T-6 N R-1 E  
10 miles West of New Albany  
(distance) (direction) (nearest town)

WELL PURPOSE: Home  
(home, irrigation, municipal, industrial)

- WELL COMPLETION DATA:
- (1) diameter (inches) 4"
  - (2) total depth (feet) 570
  - (3) static water level (feet) 110 below top of ground.
  - (4) casing PVC 200'  
(material) (depth)  
4" if telescope see back.  
(size)
  - (5) screen NONE  
(length) (depth to top)
  - (6) pump 3/4 10  
(HP) (yield gpm)  
Elec  
(type power)
  - (7) electric log NO  
(yes or no)  
(organization running log)
  - (8) how well bottom plugged OPEN

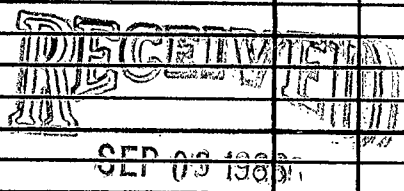


Department of Natural Resources  
Bureau of Land & Water Resources

DRILLERS REMARKS:

If well telescopes please  
sketch and show depths.

GROUND LEVEL

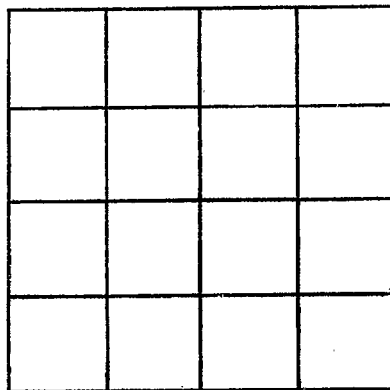

SECTION \_\_\_\_\_

Please indicate well location X.

ADDITIONAL INFORMATION

If more than one screen,  
show locations of each on sketch.