

UNION  
A 2019

MISSISSIPPI  
BOARD OF WATER COMMISSIONERS  
416 North State Street  
Jackson, Mississippi 39201

WATER WELL DRILLERS LOG

SEPT 1986  
date well completed

LEEPER Drilling  
firm name

UNION  
county well located

LANDOWNER: <u>KENNETH RHEA</u> <u>RT 2 Hickory Flat MS.</u>	description of formations encountered	from	to
(mailing address)	<u>TOP CLAY</u>	<u>0</u>	<u>20</u>
WELL LOCATION: sec. <u>30</u> T. <u>6</u> N. R. <u>1</u> (E) (S) W <u>CORNEVILLE Community</u> miles of (nearest town)	<u>BLUE CLAY</u>	<u>20</u>	<u>300</u>
WELL PURPOSE: <u>HOME</u> (home, irrigation, municipal, industrial)	<u>CHALK</u>	<u>300</u>	<u>500</u>
WELL COMPLETION DATA: (1) diameter (inches) <u>4"</u>	<u>SAND</u>	<u>500</u>	<u>565</u>
(2) total depth (feet) <u>565</u>			
(3) static water level (feet) <u>48</u> <u>below</u> above top of ground.			
(4) casing <u>PVC</u> <u>200</u> (material) (depth)			
<u>4"</u> if telescope see back. (size)			
(5) screen _____ (length) (depth to top)			
(size) (material)			
(6) pump <u>1HP</u> <u>10</u> (HP) (yield gpm)			
<u>ELEC</u> (type power)			
(7) electric log <u>NO</u> (yes or no)			
(organization running log)			
(8) how well bottom plugged <u>OPEN</u>			
DRILLERS REMARKS:			


RECEIVED

NOV 6 1986

Department of Natural Resources  
Bureau of Land & Water Resources

If well telescopes please  
sketch and show depths.

GROUND LEVEL

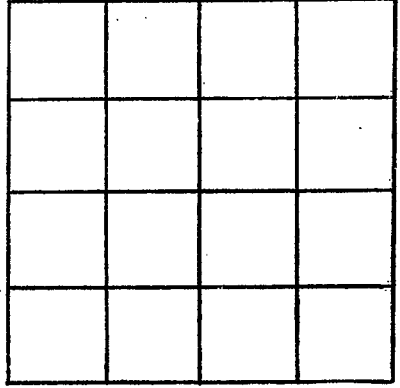

SECTION \_\_\_\_\_

Please indicate well location X.

ADDITIONAL INFORMATION

If more than one screen,  
show locations of each on sketch.