

UNION
A 2020

MISSISSIPPI
BOARD OF WATER COMMISSIONERS
416 North State Street
Jackson, Mississippi 39201

WATER WELL DRILLERS LOG

10/21/86 date well completed LEEPER DRILLING firm name UNION county well located

LANDOWNER: Ricky MARTIN
RT 2 Hickory Flat
Mississ. pp.
(mailing address)

| description of formations encountered | from | to |
|---------------------------------------|------|-----|
| TOP CLAY | 0 | 20 |
| BLUE CLAY | 20 | 300 |
| Chalk | 300 | 500 |
| SAND | 500 | 565 |

WELL LOCATION:
sec. 30 T 6 N R 1 E
5 W
CORNEVILLE Community
miles of (distance) (direction) (nearest town)

WELL PURPOSE: HOME
(home, irrigation, municipal, industrial)

- WELL COMPLETION DATA:
- (1) diameter (inches) 4"
 - (2) total depth (feet) 565'
 - (3) static water level (feet) 40 below top of ground.
 - (4) casing PVC, 200',
(material) (depth)
4" If telescope see back.
(size)
 - (5) screen _____
(length) (depth to top)
(size) (material)
 - (6) pump 1 HP 10
(HP) (yield gpm)
ELEC
(type power)
 - (7) electric log NO
(yes or no)
 - (organization running log)
 - (8) how well bottom plugged OPEN

RECEIVED


NOV 6 1986

Department of Natural Resources
Bureau of Land & Water Resources

DRILLERS REMARKS:

If well telescopes please sketch and show depths.

GROUND LEVEL

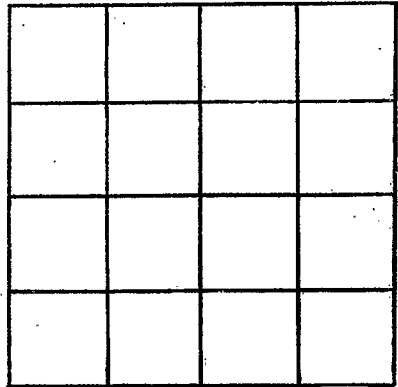

SECTION _____

Please indicate well location X.

ADDITIONAL INFORMATION

If more than one screen, show locations of each on sketch.