

Union
A 2021

MISSISSIPPI
BOARD OF WATER COMMISSIONERS
416 North State Street
Jackson, Mississippi 39201

WATER WELL DRILLERS LOG

Oct 1986 Leeper Drilling Union
date well completed firm name county well located

LANDOWNER: Bill Coker
RT 2 Hickory Flat, MS
(mailing address)

description of formations encountered	from	to
TOP CLAY	0	20
BLUE CLAY	20	300
CHALK	300	500
SAND	500	570

WELL LOCATION:
sec 31 T 6 N R 1 E
Coopersville Community
(distance) miles (direction) of (nearest town)

WELL PURPOSE:
(home) Irrigation, municipal, industrial

- WELL COMPLETION DATA:
- (1) diameter (inches) 4"
 - (2) total depth (feet) 570'
 - (3) static water level (feet) 70' below top of ground
 - (4) casing (material) PVC, (depth) 200 FT
4" (size) if telescope see back.
 - (5) screen (length) (depth to top) (size) (material)
 - (6) pump 1 HP (HP) 15 (yield gpm)
elec (type power)
 - (7) electric log NO (yes or no)
(organization running log)
 - (8) how well bottom plugged OPEN

RECEIVED


NOV 6 1986

Department of Natural Resources
Bureau of Land & Water Resources

DRILLERS REMARKS:

If well telescopes please
sketch and show depths.

GROUND LEVEL

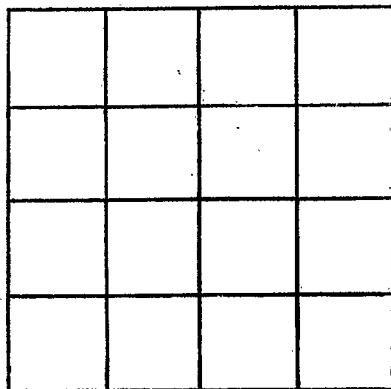

SECTION _____

Please indicate well location X.

ADDITIONAL INFORMATION

If more than one screen,
show locations of each on sketch.