

MISSISSIPPI DEPARTMENT OF NATURAL RESOURCES

Bureau of Land and Water Resources

Southport Mall

P.O. Box 10631

Jackson, Mississippi 39209

WATER WELL DRILLERS LOG

Union
A 2023

MAY 19 87 date well completed ZEEPER Drilling firm name Union county well located

LANDOWNER: Bill Bickers
RFD ETTA MS

description of formations encountered	from	to
TOP CLAY	0	20
BLUE CLAY	20	350
CHALK	350	480
NEW ALBANY SAND	480	545

(mailing address)
WELL LOCATION:
sec. 28 T. 6 N. R. 1 E
13 miles NW of NEW ALBANY
(distance) (direction) (nearest town)

WELL PURPOSE: Home
(home, irrigation, municipal, industrial)

- WELL COMPLETION DATA:
- (1) diameter (inches) 4"
 - (2) total depth (feet) 545
 - (3) static water level (feet) 115 ^{below} / _{above} top of ground.
 - (4) casing MC 200'
(material) (depth)
4" if telescope see back.
(size)
 - (5) screen NONE
(length) (depth to top)
(size) (material)
 - (6) pump 1 10
(HP) (yield gpm)
ELEC
(type power)
 - (7) electric log NO
(yes or no)
(organization running log)
 - (8) how well bottom plugged OPEN

RECEIVED


MAY 18 1987

Department of Natural Resources
Bureau of Land & Water Resources

DRILLERS REMARKS:

If well telescopes please sketch and show depths.

GROUND LEVEL

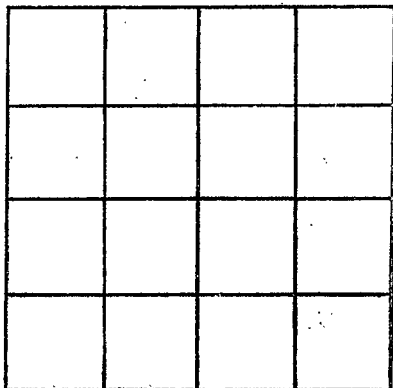

SECTION _____

Please indicate well location X.

ADDITIONAL INFORMATION

If more than one screen,
show locations of each on sketch.