

MISSISSIPPI DEPARTMENT OF NATURAL RESOURCES

Bureau of Land and Water Resources

Southport Mall

P.O. Box 10631

Jackson, Mississippi 39209

WATER WELL DRILLERS LOG

Union  
A 2024

April 1987 Leeper Drilling Union  
date well completed firm name county well located

LANDOWNER: Charles Jenkins

RT 1 ETTA MS

(mailing address)

WELL LOCATION:

sec. 28 T. 6 N. R. 1 E.  
13 miles NW of New Albany  
(distance) (direction) (nearest town)

WELL PURPOSE: Home  
(home, irrigation, municipal, industrial)

WELL COMPLETION DATA:

- (1) diameter (inches) 4"
- (2) total depth (feet) 600
- (3) static water level (feet) 134 below top of ground.
- (4) casing PVC 200' (material) (depth)  
4" (size) if telescope see back.
- (5) screen NONE (length) (depth to top)
- (6) pump 1 (HP) 10 (yield gpm)  
ELEC (type power)
- (7) electric log NO (yes or no)

(organization running log)

(8) how well bottom plugged OPEN

DRILLERS REMARKS:

description of formations encountered

from to

TOP clay	0	30
Blue clay	30	100
BROWN SAND	100	140
BLUE CLAY	100	400
CHALK	400	520
SAND	520	600


RECEIVED

MAY 18 1987

Department of Natural Resources  
Bureau of Land & Water Resources

If well telescopes please sketch and show depths.

GROUND LEVEL

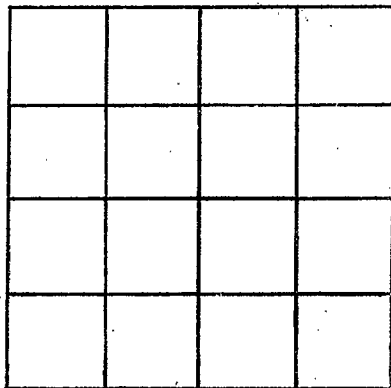

SECTION \_\_\_\_\_

Please indicate well location X.

ADDITIONAL INFORMATION

If more than one screen, show locations of each on sketch.