

# MISSISSIPPI DEPARTMENT OF NATURAL RESOURCES

Bureau of Land and Water Resources

P.O. Box 10631  
Jackson, Mississippi 39209  
WATER WELL DRILLERS LOG

COUNTY WELL LOCATED <b>UNION</b>	
WELL NUMBER <b>A</b>	CODED
DATE WELL COMPLETED <b>2020 OCT 87</b>	

PERMIT NUMBER
NAME OF DRILLING FIRM <b>Leeper Drilling</b>
<b>Pontiac</b>

NAME & MAILING ADDRESS OF LANDOWNER <b>John L Boatner</b>			
<b>RED</b>			
<b>New Albany MS</b>			
WELL LOCATION: SEC	TOWNSHIP	RANGE	
<b>19</b>	<b>6</b>	<b>1</b>	
DISTANCE		DIRECTION	NEAREST TOWN
<b>3</b> Miles		<b>E</b>	<b>Cornesville</b>
OTHER LANDMARK			
WELL PURPOSE: Home, Irrigation, Municipal, Industrial, Fish Pond, etc. <b>Home</b>			

PUMP DATA		
PUMP TYPE (Circle One): Submersible, Turbine, <b>Jet</b> Flowing Well, Other (Describe)		
POWER TYPE (Circle One): <b>Electric</b> , Tractor, Diesel, Gasoline, Butane, Other (Describe)		
Pump Capacity (GPM) <b>10</b>	No. of Stages <b>2</b>	Setting Depth <b>100</b> FT.
PUMP TEST		
Well yielded _____ GPM with a drawdown of _____ ft. after _____ hours of pumping		

WELL DATA		
Well Depth <b>620</b>	Casing Diameter (In.) <b>4"</b>	Casing Length (Ft.) <b>200 ft</b>
Type of Casing <b>PVC</b>	Hole Depth <b>620</b>	Depth to Static Water Level <b>70</b>
TYPE OF COMPLETION: (Circle One or More): Gravel Packed, Underreamed, Telescoped, Natural Development, <b>Open Hole</b> , Other (Describe)		
Top of Lap Pipe or Reduction in Casing  FEET IF TELESCOPED OR MORE THAN ONE SCREEN: USE BACK PAGE		

LOG DATA	
TYPE OF LOG RUN (Circle One): Electric, Gamma Ray, Density, Sonic, <b>No Log Run</b> , Neutron, Other (Describe)	
Name of Organization Running Log	

SCREEN DATA		
Diameter - Inches	Length - Feet	Slot Size - Inches
Screen Type	Depth to Bottom - Feet	

GEOLOGIC DATA (Office Use Only)			
Surface Elev.	Geologic Unit	Unit Thickness	Depth to Top
Subs. SWL	Date	Analysis	Aquifer Test

Driller's Remarks

DESCRIPTION OF FORMATIONS ENCOUNTERED	FROM	TO	FORMATIONS (continued) FROM TO
<b>TOP CLAY</b>	<b>0</b>	<b>20</b>	
<b>Blue clay</b>	<b>20</b>	<b>300</b>	
<b>Chalk</b>	<b>300</b>	<b>560</b>	
<b>Sand</b>	<b>560</b>	<b>620</b>	

RECEIVED


DEC 10 1987

Department of Natural Resources  
Bureau of Land & Water Resources

IF MORE SPACE IS NEEDED, USE BACK

If well telescopes please  
sketch and show depths.

GROUND LEVEL

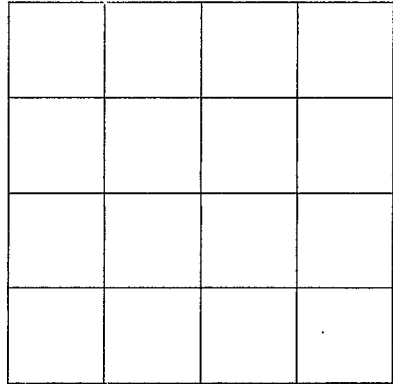

SECTION \_\_\_\_\_

Please indicate well location X.

ADDITIONAL INFORMATION

If more than one screen,  
show location of each on sketch.