

B13
1-17-61

WATER WELL DRILLERS LOG

CODED

Date: Jan. 17, 1961, Driller: Layne-Central Co. County Union

(Name)

thick
ness

(1) Owner of Land: Union County Bd. Educa.
(Name)

Myrtle School - Myrtle, Miss.
(Address)

(2) Location: 1/4, 1/4, Sec. T R
miles of
(distance) (direction) (Nearest Town)

(3) Topography: (Hilly) (Flat) (Level)

(4) Purpose of Well: School
(Domestic Irrigation
Municipal, Industrial, Other)

Description & Color of Materials Sand, Clay, Red Clay, Shell, etc.	depth	Thick- ness Feet	Depth Feet
brown clay	25	0	0 - 25
black shale-hard	185	25	25-210
sand rock	2	210	210-212
shale	5	212	212-217
sand rock	1	217	217-218
shale	5	218	218-223
hard rock	1	223	223-224
shale	4	224	224-228
rock	1	228	228-229
shale	2	229	229-231
sand rock	3	231	231-234
shale	7	234	234-241
fine sand	5	241	241-246
shale	20	246	246-266
hard rock	2	266	266-268
shale	33	268	268-301
hard rock	2	301	301-303
sand rock	3	303	303-306
hard shale	7	306	306-313
limestone & sand	28	313	313-341
rock	1	341	341-342
sand, stks limestone	22	342	342-364
hard shale	91	364	364-455

Information upon completion of well:

(1) Diameter 8 1/2 inches.

(2) Total Depth 360 feet.

(3) Water Level 58 feet below top of ground.

(4) Cased to 319, Size 8 x 6


(5) Screen: Size 4", Length 40'

(6) Were any formations sealed against pollution?
X yes, no.

If YES depth of formation 319'

Why Required

Drillers Remarks:

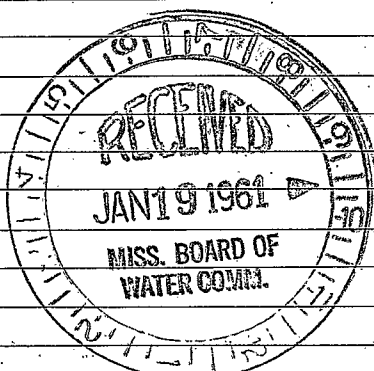

(Use Back Side)

Well No.

(x)