

UNION

MISSISSIPPI BOARD OF WATER COMMISSIONERS

**CODED**

**WATER WELL DRILLERS LOG**

B14  
12-20-67

Date: Dec 20, 1967, Driller: Clark Bros. County Union

(Name)

(1) Owner of Land: Crawford Crain  
(Name)

Description & Color of Materials  
Sand, Clay, Red Clay, Shell, etc.

Thick-  
ness  
Feet

Depth  
Feet

Route 1, Myrtle  
(Address)

Red clay 20 20

(2) Location: SE 1/4, SW 1/4, Sec. 17 T65R2E

Rock & Sand 40 60

8 miles west of New Albany  
(distance) (direction) (Nearest Town)

Blue mud 100 160

(3) Topography: Hilly  
(Hilly) (Flat) (Level)

Rock & Sand 10 170

(4) Purpose of Well: Home use  
(Domestic Irrigation  
Municipal, Industrial, Other)

Blue mud 80 250

Rock & Sand 80 330

**CODED**

Information upon completion of well:

(1) Diameter 4 inches.

(2) Total Depth 330 feet.

(3) Water Level 45 feet below top of ground.

(4) Cased to 66, Size 4 in.

(5) Screen: Size None, Length None


(6) Were any formations sealed against pollution?

yes,  no.

If YES depth of formation \_\_\_\_\_

Why \_\_\_\_\_

Drillers Remarks: \_\_\_\_\_

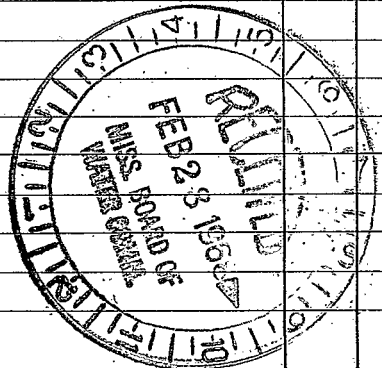

(Use Back Side)

Well No.

