

UNION
B15
11-18-70

MISSISSIPPI
BOARD OF WATER COMMISSIONERS
416 North State Street
Jackson, Mississippi 39201

CODED

WATER WELL DRILLERS LOG

Nov. 18 1970 Ed Clark Con. Union
date well completed firm name county well located

LANDOWNER:

Charles Grisco

Maple, R. 2
(mailing address)

WELL LOCATION:

sec. 23 T6 R2
6 miles NW of New Albany
(distance) (direction) (nearest town)

WELL PURPOSE:

Home
(home, irrigation, municipal, industrial)

WELL COMPLETION DATA:

- (1) diameter (inches) 5"
- (2) total depth (feet) 308'
- (3) static water level (feet) 30' below top of ground.
- (4) casing metal, 97' (material) (depth)
5" (size) if telescope see back.
- (5) screen none (length) (depth to top)
(size) (material)
- (6) pump 1 1/2 Sub. 10 (HP) (yield gpm)
Electric (type power)
- (7) electric log no (yes or no)

(organization running log)

(8) how well bottom plugged RW

description of formations encountered

from to

Clay	0	20
Rock & sand	20	80
Blue mud	80	160
Rock & sand	160	220
Blue mud	220	260
Rock of sand	260	308

CODED


JAN 4 - 1971

MISS. BD. OF
WATER COMM.

DRILLERS REMARKS:

If well telescopes please
sketch and show depths.

GROUND LEVEL

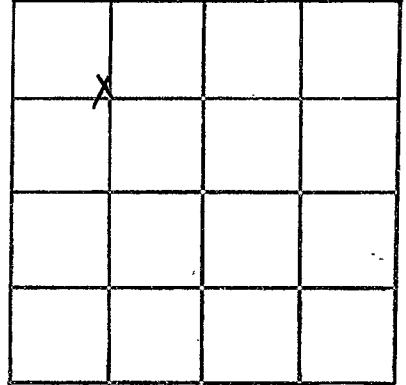

SECTION _____

Please indicate well location X.

ADDITIONAL INFORMATION

If more than one screen,
show locations of each on sketch.