

UNION
 B 16
 8-14-68

MISSISSIPPI
 BOARD OF WATER COMMISSIONERS
 416 North State Street
 Jackson, Mississippi 39201

CODED

CODED

WATER WELL DRILLERS LOG

UNION

Aug 14 1968 J.T. Mullin
 date well completed firm name county well located

LANDOWNER: Mrs. [unclear]
 Mrs. [unclear]
 Miss [unclear]
 (mailing address)

description of formations encountered	from	to
white clay	0	19
rock	19	67
blue clay	67	125
Red H. sand	125	125
white sand	125	190
blue clay	190	218

WELL LOCATION:
 sec. 13 T. 6 N. R. 2 E
 1/2 miles N of [unclear]
 (distance) (direction) (nearest town)

WELL PURPOSE:
 (home, irrigation, municipal, industrial)

- WELL COMPLETION DATA:
- (1) diameter (inches) 4 1/2
 - (2) total depth (feet) 218
 - (3) static water level (feet) 95 below above top of ground.
 - (4) casing Plastic 90 (material) (depth)
 (size) if telescope see back.
 - (5) screen (length) (depth to top)
 (size) (material)
 - (6) pump 1/3 450 (HP) (yield gpm)
 E (type power)
 - (7) electric log (yes or no)
 (organization running log)
 - (8) how well bottom plugged

CODED


JUN 27 1968

MISS. BD. OF
 WATER COMMISSIONERS

DRILLERS REMARKS:

If well telescopes please sketch and show depths.

GROUND LEVEL

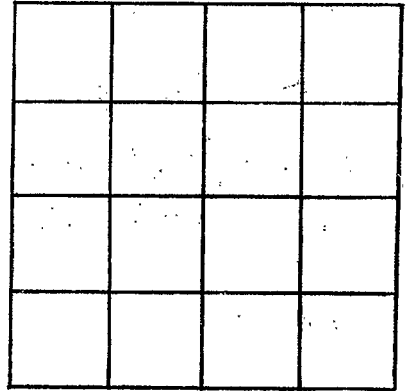

SECTION _____

Please indicate well location X.

ADDITIONAL INFORMATION

If more than one screen, show locations of each on sketch.