


1966 well

ALL MEASUREMENTS TAKEN FROM (GROUND) (TOP OF FOUNDATION) (TOP OF CASING) (TOP BASE PLATE)

RECEIVED  
 05-08-2019  
 BY OLWR

DRAWING OF THE WELL

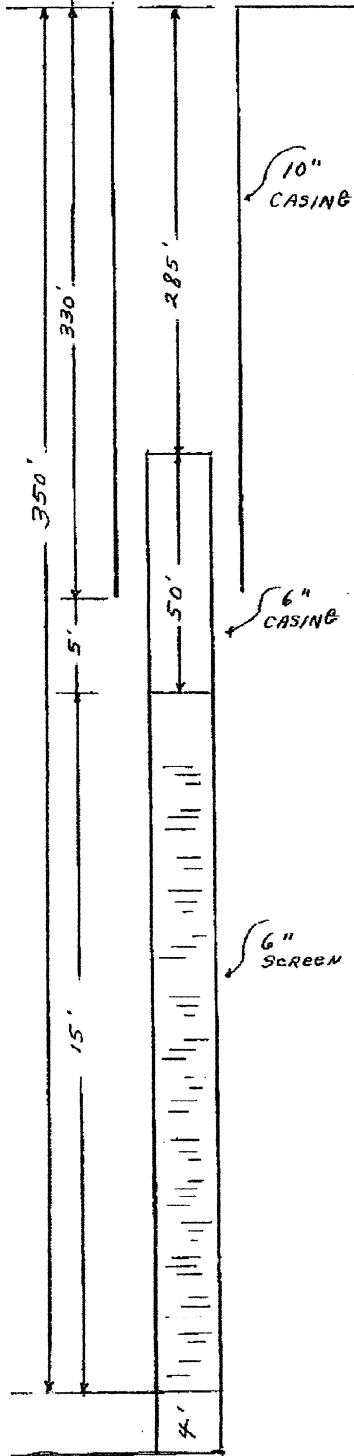

WELL DATA	STARTED WELL	2-7-	1966	AND COMPLETED	3-4-	1966	
	TOTAL DEPTH	350'	ELEVATION	STATIC WATER LEVEL		81'	
	LENGTH SURFACE CASING		SIZE	THICKNESS			
	CEMENTED WITH		SACKS CEMENT	TYPE PACKER			
	LENGTH WELL CASING	330'	SIZE	10"	WEIGHT T&C		
	CEMENTED WITH	235	SACKS CEMENT	TYPE PACKER			
	INNER CASING LENGTH	50'	SIZE	6"	WEIGHT welded		
	WITH 3' TOP 10' BOTTOM	GUIDES LOCATED		TYPE BACKOFF LH-STD			
	LEAD SEAL	BACKPRESSURE VALVE		GUIDE			
	WELL STRAINER MAKE	Layne	SIZE	6"	LENGTH	15'	OPENING 7 1/2
PUMP RECORD	TYPE MATERIAL	S.S. shutter	WITH		CONNECTIONS		
	SIZE HOLE DRILLED FOR SURFACE CASING	WITH					
	SIZE HOLE DRILLED FOR WELL CASING	WITH					
	SIZE HOLE DRILLED FOR STRAINER	WITH					
	YARDS OF GRAVEL USED	3 1/2	HOW PLACED		poured		
	HOW WAS WELL DEVELOPED	air					
	NOTES:						
	RIG USED	HP #2	DRILLER		Merrill Chrestman		
	SERIAL NUMBER	53973	MAKE	Layne	TYPE FOUNDATION	TF413	
	LENGTH COLUMN	210'	SIZE	5" x 1" x 1-1/2"	TYPE OIL	@10' LENGTHS	
BOWL SIZE	8"	TYPE	URHC	STAGES	12	MATERIAL IMPELLER	bronze
MATERIAL BOWL	C.I. WITH OPEN PORTS AND		SHAFT				
SUCTION SIZE	4"	LENGTH	20'	SUCTION STRAINER		no	
IS PUMP SEALED HOW	no	WHERE	WITH WHAT				
LUBRICATOR TYPE	electric	SIZE	1 qt.	VOLTAGE		440	
LENGTH OF AIRLINE	none	SIZE	TYPE MATERIAL				
AIR RELEASE VALVE TYPE	Crispin	SIZE					
SIZE SURFACE DISCHARGE	4"	TYPE	flanged	DAYTON COUPLING	yes		
PRESSURE GAUGE	SIZE PULLEY		SPEED				
NOTES:							
RIG USED TO SET PUMP	INSTALLER		W. H. Williams				
DATE PUMP INSTALLED	3-25-	1966	DATE IN OPERATION	19			
MOTOR	MAKE	U.S.	HP	15	FRAME	284 UPH	
	PHASE	3	CYCLE	60	VOLT	220/440	
	SPEED	1800	TYPE	HU	SERIAL NUMBER	2948937	
	TOP BEARING	BOTTOM BEARING		RATCHET			
GEAR	STARTER	PRESSURE SWITCH		FLOAT			
	MAKE	STYLE	SIZE	RATIO	NO.		
ENGINE	SIZE PULLEY	TYPE MOTOR FRAME					
	MAKE	STYLE	HP	SERIAL NUMBER			
	SPEED	SIZE PULLEY	FOUNDATION				
	TYPE FUEL TANK	MAKE MAG.		NO.			
	MAKE STARTER	NO.	TYPE FUEL				
MAKE FLEXIBLE SHAFT	SIZE	LENGTH	BELT LENGTH				
GENERAL	PURPOSE FOR WHICH THIS WATER IS USED						
	TEMPERATURE	IS WATER CLEAR		CAPACITY			
	SAND	HARDNESS	PH	IRON	NACL		
	TYPE TREATMENT USED						
	IS THERE A DERRICK OVER THE WELL	HEIGHT	TYPE				
	CAN TRUCK OR RIG EASILY GET TO WELL						
PUMP HOUSE	SIZE HATCH						

CONTRACT NO. 10322 - 100

OUR WELL NO. \_\_\_\_\_ THEIR WELL NO. \_\_\_\_\_ IN TEST HOLE NO. 1

LOCATION OF THE WELL Beside Office

INSTALLED FOR Laher Spring & Electric Car Corporation

ADDRESS CITY New Albany COUNTY Union STATE Miss

YEAR 1966