

UNION MISSISSIPPI BOARD OF WATER COMMISSIONERS

B29

8-26-60

WATER WELL DRILLERS LOG

B300

Date: 8-26, 1960, Driller: J. S. Mays

CODED

(Name)

(1) Owner of Land: Delmar Robbins
(Name)

Myrtle
(Address)

(2) Location: Block 8 1/4 N 1/4 Sec 17 T6 R28

in miles (distance), of Myrtle (Nearest Town)

(3) Topography: Hilly
(Hilly) (Flat) (Level)

(4) Purpose of Well: Domestic
(Domestic Irrigation, Municipal, Industrial, Other)

Description & Color of Materials Sand, Clay, Red Clay, Shell, etc.	Thick- ness Feet	Depth Feet
<u>red clay</u>	<u>35</u>	<u>35</u>
<u>Black shale</u>	<u>200</u>	<u>235</u>
<u>rock</u>	<u>30</u>	<u>265</u>
<u>sand</u>	<u>5</u>	<u>270</u>
<u>Blue marl</u>	<u>28</u>	<u>298</u>
<u>rock & sand</u>	<u>18</u>	<u>316</u>
<u>Blue marl</u>	<u>50</u>	<u>366</u>
<u>sand & rock</u>	<u>50</u>	<u>416</u>

Information upon completion of well:

(1) Diameter 4 inches.

(2) Total Depth 400 feet.

(3) Water Level 79 feet below top of ground.

(4) Cased to 105, Size 4

(5) Screen: Size _____, Length _____


(6) Were any formations sealed against pollution?
_____ yes, _____ no.

If YES depth of formation _____

Why _____

Drillers Remarks: _____

CODED

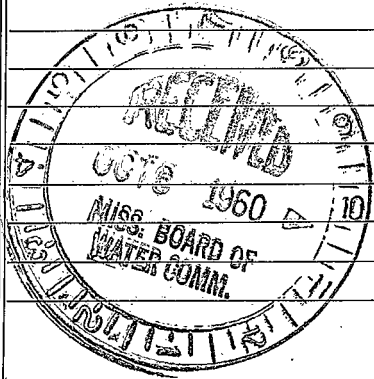

(Use Back Side)

Well No. B300

