

UNION MISSISSIPPI BOARD OF WATER COMMISSIONERS

B30

9-14-60

WATER WELL DRILLERS LOG

CODED

B301

Date: 9-14, 1960, Driller: J. J. Mancy County Union
 (Name)

(1) Owner of Land: Doyle Cooper
 (Name)

Myrtle R.S. 2
 (Address)

(2) Location: S. Half $\frac{1}{4}$, N $\frac{1}{2}$, Sec. 21, T. 6, R. 28

3 miles N.W., of New Albany
 (distance) (direction) (Nearest Town)

(3) Topography: flat
 (Hilly) (Flat) (Level)

(4) Purpose of Well: Domestic
 (Domestic Irrigation
 Municipal, Industrial, Other)

Description & Color of Materials Sand, Clay, Red Clay, Shell, etc.	Thick- ness Feet	Depth Feet
<u>soil & clay</u>	<u>30</u>	<u>30</u>
<u>blue shale</u>	<u>40</u>	<u>70</u>
<u>Rock</u>	<u>58</u>	<u>128</u>
<u>blue marl</u>	<u>60</u>	<u>170</u>
<u>Rock & sand</u>	<u>62</u>	<u>230</u>

Information upon completion of well:

(1) Diameter 4 inches.

(2) Total Depth 230 feet.

(3) Water Level 41 feet below top of ground.

(4) Cased to 63 1/2, Size 4

(5) Screen: Size _____, Length _____

(6) Were any formations sealed against pollution?


_____ yes, _____ no.

If YES depth of formation _____

Why _____

Drillers Remarks: _____

CODED

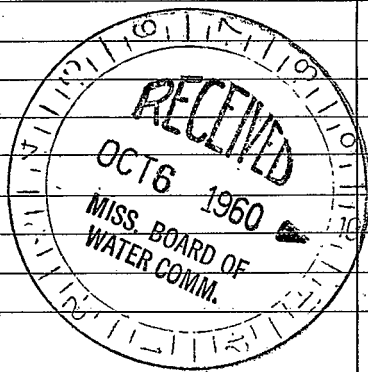

(Use Back Side)

Well No
B301

