

Union
B34
5-4-72

MISSISSIPPI
BOARD OF WATER COMMISSIONERS
416 North State Street
Jackson, Mississippi 39201

CODED

WATER WELL DRILLERS LOG

5-4 1972 Ed Clark Union
date well completed firm name county well located

LANDOWNER:
P. E. Palmer
Rt. 1, Myrtle
(mailing address)

| description of formations encountered | from | to |
|---------------------------------------|------------|------------|
| <u>Shambo</u> | <u>0</u> | <u>30</u> |
| <u>Red clay</u> | <u>30</u> | <u>90</u> |
| <u>Blue mud</u> | <u>90</u> | <u>195</u> |
| <u>Rock & sand</u> | <u>195</u> | <u>250</u> |
| <u>Blue mud</u> | <u>250</u> | <u>380</u> |
| <u>Rock & sand</u> | <u>380</u> | <u>462</u> |

WELL LOCATION:
sec. 30 T. 6 S. R. 2 E.
3 miles W of Myrtle
(distance) (direction) (nearest town)

WELL PURPOSE: Home
(home, irrigation, municipal, industrial)

- WELL COMPLETION DATA:
- (1) diameter (inches) 4"
 - (2) total depth (feet) 462'
 - (3) static water level (feet) 80' below above top of ground.
 - (4) casing Galv., 100' (material) (depth)
4" (size) If telescope see back.
 - (5) screen None (length) (depth to top)
(size) (material)
 - (6) pump (HP) (yield gpm)
Electric (type power)
 - (7) electric log no (yes or no)
(organization running log)
 - (8) how well bottom plugged no

CODED


SEP 20 1972

DRILLERS REMARKS:

MRS. R. L. OF
ISSUED DOWN

If well telescopes please sketch and show depths.

GROUND LEVEL

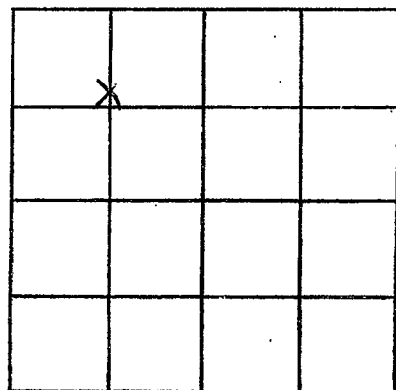

SECTION _____

Please indicate well location X.

ADDITIONAL INFORMATION

If more than one screen, show locations of each on sketch.