

UNION
B 35
7-15-72

MISSISSIPPI
BOARD OF WATER COMMISSIONERS
416 North State Street
Jackson, Mississippi 39201

CODED

WATER WELL DRILLERS LOG

7-15 1972 Ed Clark Union
date well completed firm name county well located

LANDOWNER:
Killing, Sotterwhite
Rt 4, New Albany
(mailing address)

description of formations encountered	from	to
Gravel	0	30
Red Clay	30	70
Blue A		
Rock & sand	70	140
Blue mud	140	170
Rock & sand	170	200

WELL LOCATION:
sec 33 T 6 N R 2 E
3 miles S.W. of Arzano
(distance) (direction) (nearest town)

WELL PURPOSE: None
(home, irrigation, municipal, industrial)

WELL COMPLETION DATA:
(1) diameter (inches) 4"
(2) total depth (feet) 200'
(3) static water level (feet) 40' below top of ground.
(4) casing: Metal 91' (material) (depth)
4" (size) if telescope see back.
(5) screen: None (length) (depth to top)
(size) (material)
(6) pump: 1 1/2 HP 5 (HP) (yield gpm)
Electric (type power)
(7) electric log: NO (yes or no)
(organization running log)
(8) how well bottom plugged: NO

CODED


SEP 20 1972

DRILLERS REMARKS:

MISS. Bd. of
WATER COMMISSIONERS
JACKSON, MISSISSIPPI

If well telescopes please sketch and show depths.

GROUND LEVEL

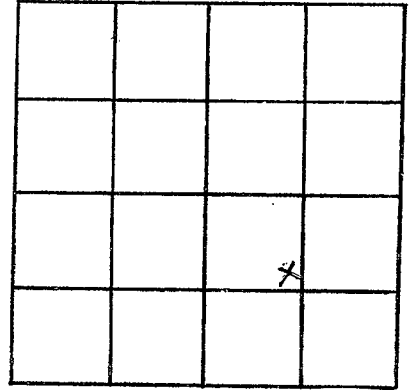

SECTION _____

Please indicate well location X.

ADDITIONAL INFORMATION

If more than one screen,
show locations of each on sketch.