

UNION
 B 38
 7-7-70

MISSISSIPPI
 BOARD OF WATER COMMISSIONERS
 416 North State Street
 Jackson, Mississippi 39201

WATER WELL DRILLERS LOG


7-7-70 date well completed 19 Jumper Well Drilling Union firm name county well located

LANDOWNER:	description of formations encountered	from	to
Walter Simpson	mess Rock & clay	0	160
New Albany, Miss - (mailing address)	Clay	160	210
WELL LOCATION: sec. 18 T. 6 N. R. 2 E 5 miles N of New Albany (distance) (direction) (nearest town)	Prod & Rock	210	265
WELL PURPOSE: (home, irrigation, municipal, industrial)			
WELL COMPLETION DATA:			
(1) diameter (inches) 4"			
(2) total depth (feet) 265			
(3) static water level (feet) 70 below top of ground			
(4) casing PVC 150 (material) (depth)			
0 (size) if telescope see back.			
(5) screen 0 (length) 0 (depth to top)			
0 (size) (material)			
(6) pump 1/2 (HP) 10 (yield gpm)			
Elex (type power)			
(7) electric log 0 (yes or no)			
0 (organization running log)			
(8) how well bottom plugged 0			
DRILLERS REMARKS:			

NOV 20 1972

If well telescopes please sketch and show depths.

GROUND LEVEL

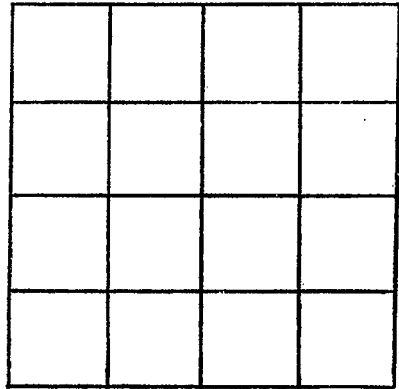

SECTION _____

Please indicate well location X.

ADDITIONAL INFORMATION

If more than one screen,
show locations of each on sketch.