

UNION
B39
10-14-72

MISSISSIPPI
BOARD OF WATER COMMISSIONERS
416 North State Street
Jackson, Mississippi 39201
WATER WELL DRILLERS LOG

CODED

date well completed Oct 14 1972 firm name Ed Clark county well located Union

LANDOWNER: Sam Ruffard
Myrtle Route 2
(mailing address)

| description of formations encountered | from | to |
|---------------------------------------|------------|------------|
| <u>Shredding</u> | <u>0</u> | <u>20</u> |
| <u>Red clay</u> | <u>20</u> | <u>60</u> |
| <u>Blue mud</u> | <u>60</u> | <u>140</u> |
| <u>Rock & Sand</u> | <u>140</u> | <u>200</u> |
| <u>Blue mud</u> | <u>200</u> | <u>250</u> |
| <u>Rock & Sand</u> | <u>250</u> | <u>312</u> |

WELL LOCATION:
sec. 23 T. 6 S. R. 2 E.
5 miles W of New Albany
(distance) (direction) (nearest town)

WELL PURPOSE: Home
(home, irrigation, municipal, industrial)

- WELL COMPLETION DATA:
- (1) diameter (inches) 4"
 - (2) total depth (feet) 312'
 - (3) static water level (feet) 32' below top of ground.
 - (4) casing Metal, 81',
(material) (depth)
4 if telescope see back.
(size)
 - (5) screen None
(length) (depth to top)
(size) (material)
 - (6) pump 1 jet 5
(HP) (yield gpm)
Electric
(type power)
 - (7) electric log no
(yes or no)
(organization running log)
 - (8) how well bottom plugged


CODED

DEC 4 1972

DRILLERS REMARKS:

If well telescopes please sketch and show depths.

GROUND LEVEL

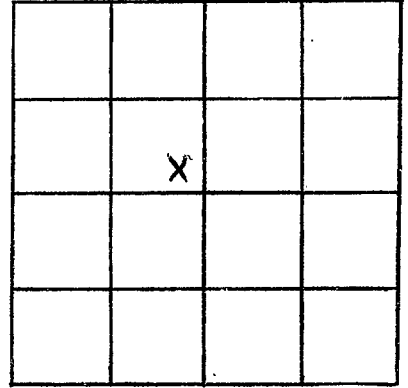

SECTION _____

Please indicate well location X.

ADDITIONAL INFORMATION

If more than one screen,
show locations of each on sketch.