

CODED

MISSISSIPPI
BOARD OF WATER COMMISSIONERS
416 North State Street
Jackson, Mississippi 39201

UNION
B 41
7-11-73

WATER WELL DRILLERS LOG

July 11 1973 Ed Clark Union
date well completed firm name county well located

LANDOWNER:

Troy Hamilton
Memphis Tenn.
(mailing address)

description of formations encountered

from to

Sand	0	40
Blue mud	40	90
Rock & Gr	90	190
Blue mud	190	230
Rock & Sand	230	264

WELL LOCATION:

sec. 24 T. 6 N. R. 2 E
5 miles N of New Albany
(distance) (direction) (nearest town)

WELL PURPOSE:

Stone
(home, irrigation, municipal, industrial)

WELL COMPLETION DATA:

- (1) diameter (inches) 4"
- (2) total depth (feet) 264'
- (3) static water level (feet) 30' below top of ground.
- (4) casing: Metal 80' (material) (depth)
4" (size) if telescope see back.
- (5) screen: Stone (length) (depth to top)
(size) (material)
- (6) pump: 1/2 (HP) 8 (yield gpm)
Electric (type-power)
- (7) electric log: yes (yes or no)

CODED

(organization running log)


(8) how well bottom plugged

DRILLERS REMARKS:

JUL 25 1973

If well telescopes please sketch and show depths.

GROUND LEVEL

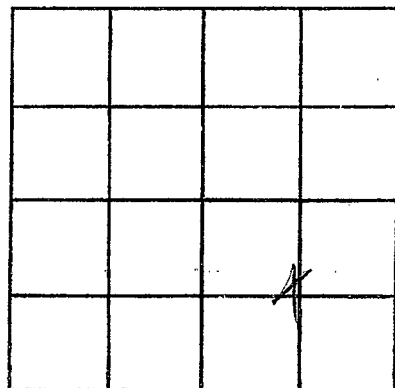

SECTION _____

Please indicate well location X.

ADDITIONAL INFORMATION

If more than one screen,
show locations of each on sketch.