

UNION
B42
5-27-73

MISSISSIPPI
BOARD OF WATER COMMISSIONERS
416 North State Street
Jackson, Mississippi 39201

CODED

WATER WELL DRILLERS LOG

5-27-73 date well completed Ed Clark firm name Union county well located

LANDOWNER:
Sam Waldorf
Myrtle, Et.
(mailing address)

| description of formations encountered | from | to |
|---------------------------------------|------|-----|
| Sand | 0 | 40 |
| Blue mud | 40 | 70 |
| Red & Grd | 70 | 170 |
| Blue mud | 170 | 240 |
| Red & Sand | 240 | 374 |

WELL LOCATION:
sec. 14 T 6 N R 2 E
7 miles N of New Albany
(distance) (direction) (nearest town)

WELL PURPOSE: Home
(home, irrigation, municipal, industrial)

- WELL COMPLETION DATA:
- (1) diameter (inches) 4"
 - (2) total depth (feet) 374'
 - (3) static water level (feet) 100' below top of ground.
 - (4) casing Metal, 100'
(material) (depth)
24 (size) if telescope see back.
 - (5) screen None
(length) (depth to top)
(size) (material)
 - (6) pump 1 1/2 HP 10
(HP) (yield gpm)
Electric
(type power)
 - (7) electric log No
(yes or no)
(organization running log)
 - (8) how well bottom plugged


CODED

DRILLERS REMARKS:

JUL 25 1973

If well telescopes please sketch and show depths.

GROUND LEVEL

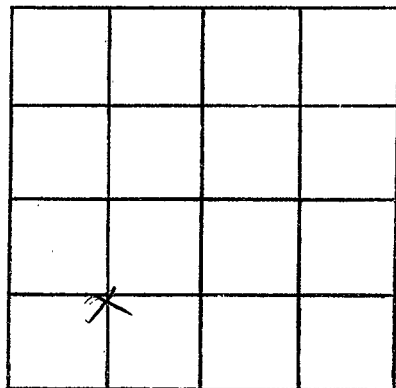

SECTION _____

Please indicate well location X.

ADDITIONAL INFORMATION

If more than one screen,
show locations of each on sketch.