

B 43  
UNION  
7-11-73

MISSISSIPPI  
BOARD OF WATER COMMISSIONERS  
416 North State Street  
Jackson, Mississippi 39201

720 00  
36 00  
756 00

WATER WELL DRILLERS LOG

7-11-1973 J T Miller Union  
date well completed firm name county well located

LANDOWNER:  
James Rodgers  
New Albany  
(mailing address)

description of formations encountered	from	to
Clay	0	16
" & rock	16	47
blue "	47	126
rock & sand	126	165
blue clay + sand	165	320

WELL LOCATION:  
sec. 25 T 6 S R 2 E  
1. miles W of PUMKIN  
(distance) (direction) (nearest town)

WELL PURPOSE:  
(home, irrigation, municipal, industrial)

**CODED**

WELL COMPLETION DATA:


- (1) diameter (inches) 4
- (2) total depth (feet) 320
- (3) static water level (feet) 11 below top of ground
- (4) casing P 20 (material) (depth)
- (size) if telescope see back.
- (5) screen 0 (length) 0 (depth to top)
- (size) (material)
- (6) pump 1 (HP) 12 (yield gpm)
- (type power)
- (7) electric log (yes or no)
- (organization running log)
- (8) how well bottom plugged

AUG 22 1973

DRILLERS REMARKS:

If well telescopes please sketch and show depths.

GROUND LEVEL

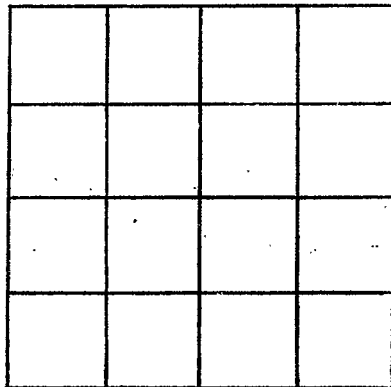

SECTION \_\_\_\_\_

Please indicate well location X.

ADDITIONAL INFORMATION

If more than one screen, show locations of each on sketch.