

UNION  
B 44  
9-26-74

MISSISSIPPI  
BOARD OF WATER COMMISSIONERS  
416 North State Street  
Jackson, Mississippi 39201

CODED

WATER WELL DRILLERS LOG

Sept 26 1974 J T Modlin UNION  
date well completed firm name county well located

LANDOWNER:  
Bobby Nelson  
New Albany  
(mailing address)

description of formations encountered	from	to
Clay	0	20
rock & clay	20	113
blue clay	130	220
rock & sand	270	360

WELL LOCATION:  
sec. 4 T. 6 N. R. 2 E.  
SW of Blue Mt.  
(distance) (direction) (nearest town)

WELL PURPOSE:  
(home, irrigation, municipal, industrial)

- WELL COMPLETION DATA:
- (1) diameter (inches) 4
  - (2) total depth (feet) 360
  - (3) static water level (feet) 30 below top of ground.
  - (4) casing P 180 (material) (depth)  
(size) if telescope see back.
  - (5) screen (length) (depth to top)  
(size) (material)
  - (6) pump 2 6 (HP) (yield gpm)  
(type power)
  - (7) electric log (yes or no)  
(organization running log)
  - (8) how well bottom plugged

DRILLERS REMARKS:


CODED

RECEIVED  
DEC 12 1974

MISS. BD. OF WATER COMM

If well telescopes please sketch and show depths.

GROUND LEVEL

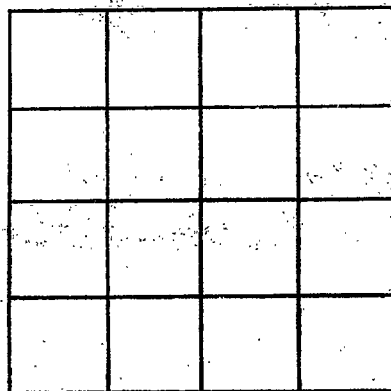

SECTION \_\_\_\_\_

Please indicate well location X.

ADDITIONAL INFORMATION

If more than one screen,  
show locations of each on sketch.