

If well telescopes please sketch and show depths.



GROUND LEVEL

10" CASING
302'

Top of LAP
262'

Top of SCREEN
302'

Bottom SCREEN
350'

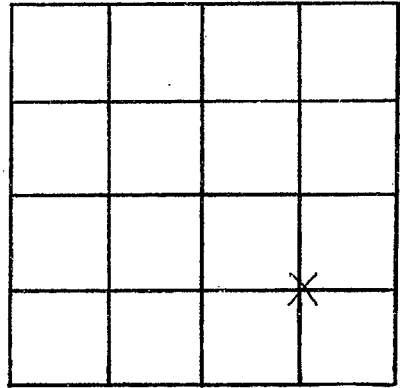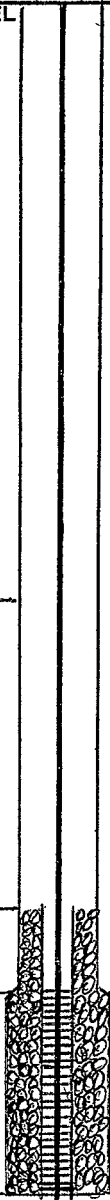

SECTION 17

Please indicate well location X.

ADDITIONAL INFORMATION

If more than one screen,
show locations of each on sketch.