

STARTED Well 9/10/68

MISSISSIPPI
BOARD OF WATER COMMISSIONERS
416 North State Street
Jackson, Mississippi 39201

CODED

WATER WELL DRILLERS LOG

Union
348 348
9-13-68

9 13 1968 date well completed JT Modlin firm name UNION county well located

LANDOWNER: MR. MARRIS
New Albany, Miss.
(mailing address)


description of formations encountered	from	to
White Clay	0	19
Rock	19	67
Blue Clay	67	153
125 Rock Sand	125	169
White Sand	169	198
Blue Clay	198	218

WELL LOCATION:
sec. 24 T. 6 N. R. 2 E W
1 1/2 miles N. of Diamond
(distance) (direction) (nearest town)

WELL PURPOSE:
(home, irrigation, municipal, industrial)

- WELL COMPLETION DATA:
- diameter (inches) 4 PLASTIC
 - total depth (feet) 218
 - static water level (feet) 40 below top of ground: above
 - casing PLASTIC 90 (material) (depth) 40 If telescope see back. (size)
 - screen (length) (depth to top) (size) (material)
 - pump 1/2 (HP) 450 (yield gpm) E (type power)
 - electric log (yes or no) (organization running log)
 - how well bottom plugged

CODED

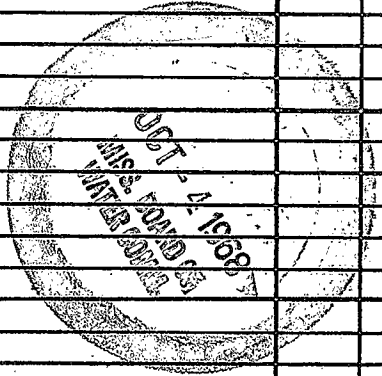


DRILLERS REMARKS:

11 SW 45 ATZ

If well telescopes please sketch and show depths.

GROUND LEVEL

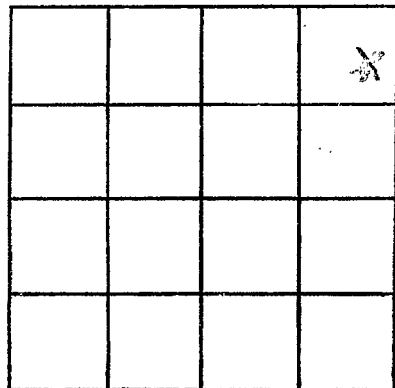

SECTION _____

Please indicate well location X.

ADDITIONAL INFORMATION

If more than one screen, show locations of each on sketch.