

Union
B 200
8/11/76

MISSISSIPPI
BOARD OF WATER COMMISSIONERS
416 North State Street
Jackson, Mississippi 39201

WATER WELL DRILLERS LOG

8/11/76 19 MEDLIN Well Drillers UNION
date well completed firm name county well located

Need Section

LANDOWNER: C. L. HOPPER	description of formations encountered	from	to
M. Y. R. T. L. E. Miss	CLAY	0	75
(mailing address)	BLUE Mud	45	250
WELL LOCATION:	SAND & Rock	250	300
sec. T 6 N R 2 E S W 4 miles EAST of MYRTLE (distance) (direction) (nearest town)			
WELL PURPOSE: HOME (home, irrigation, municipal, industrial)			
WELL COMPLETION DATA:			
(1) diameter (inches) 4			
(2) total depth (feet) 200			
(3) static water level (feet) 170 above top of ground.			
(4) casing PLASTIC, 130 (material) (depth)			
(size) If telescope see back.			
(5) screen (length) (depth to top)			
(size) (material)			
(6) pump 1/2 9 (HP) (yield gpm)			
(type power)			
(7) electric log (yes or no)			
(organization running log)			
(8) how well bottom plugged			
DRILLERS REMARKS:			


RECEIVED

DEC 2 1976

MISS. BD. OF WATER COMM

If well telescopes please
sketch and show depths.

GROUND LEVEL

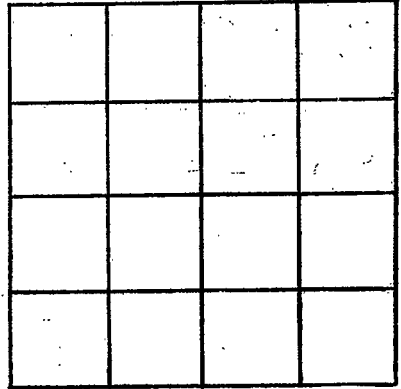

SECTION _____

Please indicate well location X.

ADDITIONAL INFORMATION

If more than one screen,
show locations of each on sketch.