

Union
B 2003
8/15/76

MISSISSIPPI
BOARD OF WATER COMMISSIONERS
416 North State Street
15F Jackson, Mississippi 39201

WATER WELL DRILLERS LOG

8/15/76 date well completed
MEDLIN WELL DRILLING CO. firm name
BRUNION county well located

LANDOWNER: R. K. Kitchens

description of formations encountered

from to

NEW ALBANY, Miss

Clay	0	40
Blue Mud	40	170
Sand and Rock	170	230

(mailing address)

WELL LOCATION:

sec 3 T 6 N R 2 E

3 miles WEST of NEW ALBANY
(distance) (direction) (nearest town)

WELL PURPOSE: HOME
(home, irrigation, municipal, industrial)

WELL COMPLETION DATA:

- (1) diameter (inches) 4
- (2) total depth (feet) 230
- (3) static water level (feet) 60 ^{below} top of ground

(4) casing Plastic, 90 FT.
(material) (depth)

(size) If telescope see back.

(5) screen (length) (depth to top)

(size) (material)

(6) pump 1/2 Sub //
(HP) (yield gpm)

(type power)

(7) electric log (yes or no)

(organization running log)

(8) how well bottom plugged

DRILLERS REMARKS:


RECEIVED

DEC 2 1976

MISSISSIPPI BOARD OF WATER COMMISSIONERS

If well telescopes please sketch and show depths.

GROUND LEVEL

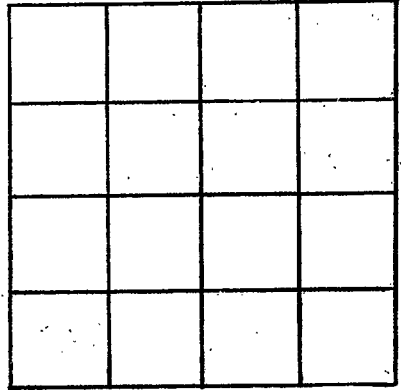

SECTION _____

Please indicate well location X.

ADDITIONAL INFORMATION

If more than one screen,
show locations of each on sketch.