

Union
 B 2003
 8/22/76

MISSISSIPPI
 BOARD OF WATER COMMISSIONERS
 416 North State Street
 Jackson, Mississippi 39201

WATER WELL DRILLERS LOG

8/22/76 15F MEDIAN WELL DRILLING CO. UNION
 date well completed firm name county well located

LANDOWNER: DONALD ELDER

NEW ALBANY MISS

(mailing address)

WELL LOCATION:

sec. T 6 N R 2 E
 21 22 (S) (W)

2 1/2 miles WEST of NEW ALBANY
 (distance) (direction) (nearest town)

WELL PURPOSE: HOME
 (home, irrigation, municipal, industrial)

WELL COMPLETION DATA:

- (1) diameter (inches) 4
- (2) total depth (feet) 220 FT.
- (3) static water level (feet) 55 below top of ground.
- (4) casing PLASTIC 85 (material) (depth)
 (size) If telescope see back.
- (5) screen (length) (depth to top)
 (size) (material)
- (6) pump 1/2 SUB 12 (HP) (yield gpm)
 (type power)
- (7) electric log (yes or no)
 (organization running log)
- (8) how well bottom plugged

description of formations encountered

from to

Clay	0	45
Clay & Rock	45	70
Blue Mud	70	80
Rock & Sand	180	220

Need sec

RECEIVED


DEC 2 1976

DRILLERS REMARKS:

MISS. BD. OF WATER COMM.

If well telescopes please sketch and show depths.

GROUND LEVEL

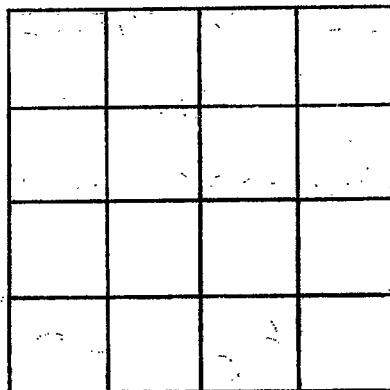

SECTION _____

Please indicate well location X.

ADDITIONAL INFORMATION

If more than one screen,
show locations of each on sketch.